
11-17-81 Set C.I.C. / P² over 1" Sq. Pipe set 11-3-81

South Section Cor. 33-34 Goodhue Co. 109-15

11-2-81 Dug from Highum Iron ___ West and ___ North by 3½' Deep found nothing. Difficult to Tell depth to dig. Much Sediment

---

11-3-81 Continued digging here Digging now as follows Found 2" diameter stake 18" long down 16" standing 13.06' West & .19' South of Highum's Iron (replaced). Removed stake to office & drove a 3/4" square pipe at its location Found nothing further Chained 158' West to upper most river bank.

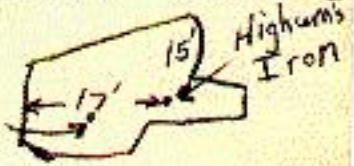

over

11-17-81 Set C.I.C./P² over 1" sq. Pipe set at the location of the Stake found 11-3-81. Left Highum's Iron in place but drove it down. This Corner 56' North of the north edge of River and in old E-W fence line.

R.P.'s

Spike & C.S.D. in 16" Basswood	N.N.W.	28.7'
spike & C.S.D. in 16" Basswood	N.E.	54.24'
spike & C.S.D. in 9" some kind of Elm	S.W.	36.92

Gov't Notes: Surveyor Elisha S. Norris Sept. 1853 Set Post for Corners to sections 33 & 34

{Elm 12" N 57° W 38 Lks.
{Linden 12" N 65° E 12 Lks.

5-20-75 Set ½" x 30" rod as corner ①

South ¼ Corner Sec 34 Goodhue Co 109-15

No data recorded in Olmsted County on corner location

5-14-75

Dug on the North side T.H. #52 + on N.W. side Twp. Road East. using a large burr oak (orig. BT. To N.W. as possible govt bearing tree. Found a 5" to 4" square limestone 12" long. about 3' deep.

5-20-75 Set a ½" x 30" rod as the corner on line from South Sec. cor 34-35 (109-15) over the N. 2-3 108-15 and at govt meas. from

S4. 34-109-15

North 2-3 108-15 - 735.24'

R.P.'s

Center 30" Burr Oak N.W. 146.0'

Conc. nail E. side tele pole # 1404 N.N.E. ~~25.78~~ gone 10-81

E side of Govt of N. Bound Lake T.H. #52 (at Rt. 45) S.W. 64.0'

Conc. nail in Guard rail W. ~~26.43~~ gone 10-81

Top center East end culvert N.W. 103'

Orig Gov't notes

Set Quarter Sec. post @ 40.00 chs.

12" Bur oak N43°W 224 lks. = 147.84'

6" Bur oak N48°E 76 lks = 50.16'

South 1/4 Corner 34 Goodhue Co. 109-15 (2)

11-9-81 Dug again to find Stone found in 1975 Found 4"x 5"x 12" (broken top) stone 3.77' east and .25' South of 1/2" rod location. Dug South and east but found nothing further. Read Brg. & distance from stone to possible Brg tree N 40°W 149' set 1/2" rod back.

11-25-1981 set C.I.C. / P² at intersection Gov't tie to Gov't Brg. tree N.W. and Closing Corner at No. 2-3 found in 1975. The Corner is 1.85' South and .12 east of 1/2" rod set in 1975 (removed). The Corner is on Northerly Slope of approach to T.H. 52 of twp. rd. running east and is 28 1/2' North of Center of blacktop Mat on Curve in the approach

R.P.'s

Easterly edge of Concrete N.B. lane T.H. 52

S.W. 62.53

spike in West Side Gout Brg. Tree N 41° 39' 56" W

147.86'

1/4 Corner Center 3 New Haven 107-15
#850309

Jan, 1861 Samuel McDowell Pg. 65 No. 92 did a Survey
of the west 7 acres of the S.W. 1/4 of the S.E. 1/4 sec. 3