9-30-85 CIM

#850404 (1)

1/4 corner 4-9 New Haven 108-15.

no court house records.

- 1966. Meas from S 1/4 5 (CIM set on corner & record found in perfect condition which is undisputed,

- set 120 D at 5280' lines fence north very close; no fence south.

-. 120 D lies 2' north south edge rock surface and .5' east of new gord fence north.


¼ Cor. Section 4-9 New Haven Twp.

Gov. Notes- Cushing, Dep. Sur. 6-12-1854
West on true line between 4-9
40.00 Set quarter post in raised mound with trench and pits.
80.00 Section corner

9-16+17+18-1985, ¼ Cor 4-9: Dug from t.n. (set in line fence North and approx 1' SO ℄ in 1979) for 4½' East, 4' South, 1½' North and 10½' West by 2½' deep at East end of hole and 2' deep at West end. Digging N-S today to cover the middle of the road and 1320 from the 1/16 N (meas. 1317.8' from nail @ ¼ 4-9 to nail at 1/16 N). Digging E-W to cover fence North and midway (came 7.6 W of t.n) Conditions only fair with black dirt looking a little mixed up and

¼ Cor 4-9 New Haven 108-15
#850404

9-16+17+18-1985, ¼ Cor 4-9 cont.: and full of small boulders which make digging into backhoe difficult. Quick change from black to clay to sand but could be natural here. Continued digging. Hole as follows:

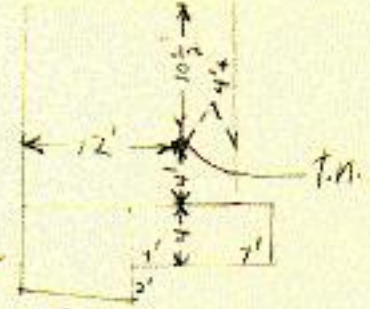


Found a small square boulder 7" x 7" x 11", standing with wood pipe lying beside. Removed stone and found that someone had dug under it. As we dug east and south we found 4 more boulders and a limestone, but none were standing and someone had dug where they lay. Stone is an area about 1½' N-S

by 2½' E-W. Small square boulder 4' South of ℄ E-W road [stone 32'± from north road fence — there is so much shoulder on So side of road it look looks like center of road could have been farther South than it is now]. Square boulder is also in line with main line of fence running North (200'±) but is 3' E. of fence at road (fence at road may have moved West because of boulder pile where fence line from North would come)

9-30-85, ½, Cor 4-9° Set CIM over a ½-rod at location square boulder stood

RP: CSD in brace post NNW 32.96