~~8-26-1966 set CIM on 1/2" x 3' rod. (relocation)~~
9-21-76 Set CIM "Correction of Corner" #850508 (1)
1/4 corner north 1/4 5 New Haven 108-15
5-1889 Thos Fraser P 428 No 416 & 5 Jewell.
Field Bk 6 p. 4-8
Corner gone, no evidence or knowledge.
Gov't 79.29
- relocated corner by M & L 39.59 2612.9 ~~R 80.29~~
set stake as corner. - set stake as 1/16 corner west
M & L 19.79 1/2
- 16 south - overrun 16 1/2 links. set 1/16 at 20.07 1/2 north of
center 5, Then 11.08 ch. N. of above 1/16. Then 11.08 To N. 1/4 6 11.040 m.f. 11.08 Bk.

11-1937 A Leonard. P 471 top page & 5 J Rock. atty.
found stone in center road. 2 RPs to poles (gone now)
- Meas south 2780.5 To stone found as center 5
- over -

- east set rod 943.4 then 1669.5 to corner
stake set on NE corner 5. total 2612.9

8-1966 J Kerr B94 P 48
dug in black top extensively. fill deep & mixed. corner in
& road south not true corner. finally set corner on line
between SW corner 32-109-15 and rod set by Leonard found.
east and at best measure to fit situation. 1434 and 944' W of rod.
- east 2610' to fence south and 722.08' east of SW 32.
- set C/M. over ½"x 3' rod. NE 5 to N¼ 4! 2636.'
- County disc SE side power pole NE 80.3
- " " tele pole NW 49.57
- " " " " SW 58.52.
corner lies. 21.43' west of center county road south.
" " 9.3 west of rod in black top claimed by Mayor
as N¼ 5

#850508

Card no 2. North 1/4 5 New Haven 108-15 (2)

6-27-72. untied reference, where C/M down some how.
trying to determine how much of lot properties East Main
street lay in Almsted County

- found 1/2" pipe found 8-1966 set by A E Leonard. 943.4.
East of stone at N 1/4 5 when it was in place.
pipe 2.5 W - 3' N of 12" elm in yard about 2' into yard from
street
- found square bridge bolt set by J Kerr. in 1930's across
street 47.84 from pipe and apparently a little south of
line pipe was set on.


over.

RPs To S 31-32 109-

See Kerr's Pine Island Book notes p. 6.

8-1934 C.H.D Book # 82 page 2 "P.I. of East and West Curves is 36.0' east of N 1/4 Cor Sec 5. on line with street monument east.

9-15-76 Dug on line from S 1/4 5 over Center 5 to cover present N. line of Sec 5 and also T.F.'s measure from Center 5. Dug 4' deep to clay found nothing. Dug again approx 20'E where we got "dep" from railroad spike found found 2 stakes 4½' deep within 1' of spike and 35.41 W and .9' N of traverse point.

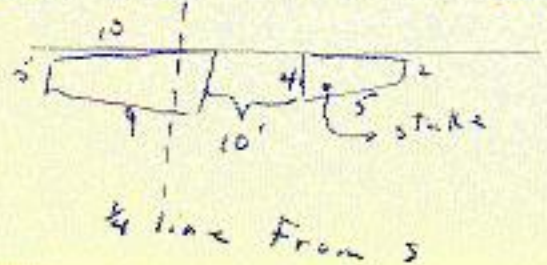

¼ Corner North ¼ 5 New Haven 108-15 (3)
#850508

9-21-76 Set CIM over ½ x 2' rod midway between NW 5 and NE 5 and on line from the CIM at S. 31-32 to the iron at 5¼ 32. Corner came 1.07' S and .23' E of stakes found. Corner lies 3' S of ℄ E-W road and 46' W of ℄ of road S and 35.12 W of rod used as traverse point. Measure to fences E & W of the ¼ line indicate stone used by A. Armstrong lies up to 4' W of stakes found but believe stakes to be T.F.'s. Removed T. Kavis CIM was .45 and 25.7 E.

R.P.'s: Punch hole top W end 24" C.M.P. to road S SE 44.60
CSO N. side pp #40 NW 159.80
U.S.G.S. Elevation Benchmark NE 104.83

11-1934 Found boulder over remains of old stake

11-1934 - C.H.D. Book # 82 page 78

Set 4"X12" base 4"X4" top 18" long limestone about ½' below the surface. Stone is 32.8' north of N.E. Cor. of Fence