1 11-2-71 found iron set ½"x 5.5' pipe N side. (1)
3-26-81 Set CIC/P²
#850604

¼ corner 6-7 New Haven 108-15.
Field Bk 5 p. 144
9-1882 Hunter P 379 No 370 & 6. W Drush and others.
Corner missing, found. NW witness tree standing and
stump & S witness tree - reset stake as corner.
-16 west set stake on line an B tree 10" cherry S 53½ W.
23½ lks.
19.92 in field BK
- Meas west 19.93 (1315.38 then 19.52 (1288.32. (15.5'
To section corner. line short- 16 links.

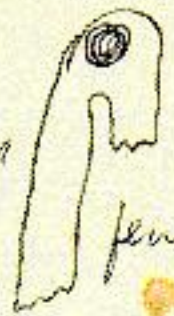
5-1900 R Fraser P 672. No 597 & 6 Devery & others
Field BK 15 P. 53-54
found stub & old stake from course and meas
- over -

from NW B.T.
- set new br. oak stake with iron rod beside stake which came. just on east side of a tree.
- On setting SE6 must from S 1/4 6 and dundas
Meas (not given) now 1966 - SW 5 to S 1/4 1 26 32.5
Mile shes short 13 lks. (8.58' for mile.
- 16 east found stake set by Hamilton (Pine Island Surv.
- used this to project line to set N-S of SE cor 6.

11-2-71 Co surv Meas from C 1/4 at 5-6-7-8 west.
found 1/16 fence cor'r at 1319. and iron rod at 2635.0
on NE side of huge elm or similar type tree (no leaves left)
set 1/2" pipe 5.5' long on N side of iron pipe 12" with S. edge
of pipe centering over rod. - also set piece of old cast

see Card #2

Card # 2 1/4 6-7 New Haven 108-15 (2)

Cont. 11-2-71. – iron pipe & hot water house radiator shaped thus  driven vertically on east side some 4" driven down flush with top of iron found #850604

Large tree in fence terminal of fence E-W-N.

Meas east to 5-6-7-8 2635.0 R 2632.5 if 5-6-7-8 set midway between S'45 & S'46 as recorded.

Meas west to 1/16 corner set, found 18" dup where very old concrete & small stones in lime type concrete had been poured around corner post now completely rotted away. 1315.63 R 1315.38 19.92 chs set old post in hole.

1/16 lines fence N & main line fence E-W. 1/4 cor RPs over.

RP to 1/4 6-7.

25.4 West To 4 D on N side 9" wrinkly bark hackberry. in fence line. Nail up 3' ±

33.42 NNW To 4 D on W side 5" 4" wrinkly bark. hackberry. Nail up 2' ±

207 ± west to east river bank.

Gov. Notes Cushing, Dep. Sur. 6-12-1854
East on true line between 6 and 7.
39.60 Set quarter section post.
Elm 15 in, N34W 13 lks.
Elm 24 in. S9EW 37 lks.
79.60 Section corner

3-26-81 Drove CIC/p² over ½" pipe fd. on NE side huge tree — corner to Fences E-W-N. Set survey marker sign & post 1.9 N
RPs above still in place