851304 (1)

1/4 Corner. 13-24. New Haven 108-15

1-1892 2 bas Fraser P468 No 450 S24 T Van Horn.
Corner gone. Nothing could be found of it. Mr D Van Horn
aneres stake stood on west side of old track. Line
run N 8 L 39.80 (2626.8' brought corner at that spot.
No desc of corner set only method employed in setting.

4-1871 Perry. P181 No 192 S24 M. C. Cullough.
found stake in mound. No mear etc.

4-1903 Ch Armstrong P490 S13 5 parties.
survey only plat, no desc.


- over -

S 1/4 13 shown as post
-16 north stake M & L. 19.90
-16 west stake shown M & L. 19.94. To fence corner.
-16 east " " " 19.94 To stone old B.T.S

Gov. Notes- Cushing, Dep. Sur. 6-12-1854
West on true line between sections 13 and 24.
40.00 Set quarter section corner. Raised mound,
dug trench, and drove charred stake as instructed
80.00 Section corner.

10-1985, 1/4 Cor 13-24: Dug as follows:

Dug M&L for corner
set by Thomas Fraser
and Co Armstrong but
could not find stake
Dug along W. edge old road
for original corner as
remembered by Mr. Van Horn

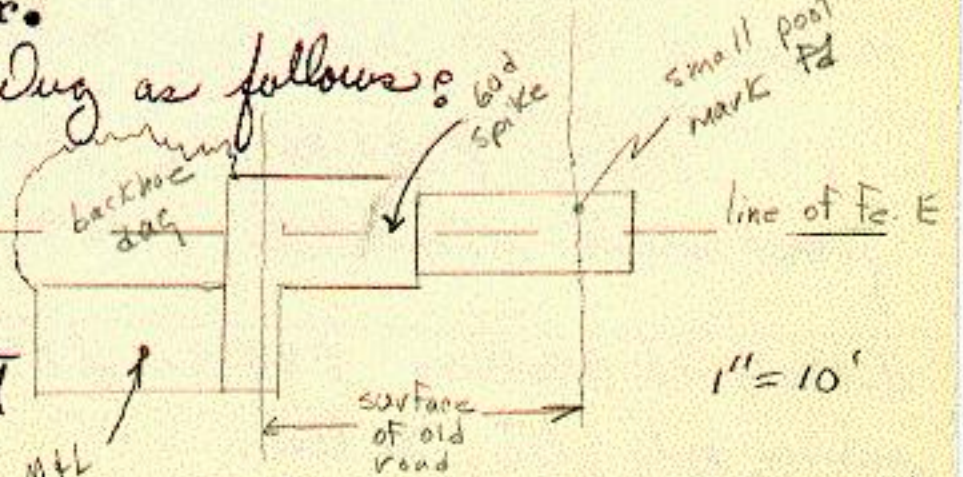

in T.F. Survey No 450, Page 468 (cont.)

¼ Corner 13-24 New Haven 108-15

#851304

10-1985, ¼ Cor 13-24, Cont: Dug across road in line with fence running east to cover line projected from the S ¼ 24 over the fe. N. at the Center 24 which came 18'± East of midway. Fd remains of a small post 17'± E and 5½'± N (17.06) (5.41) of M+L. Post had ben dug around. Drove 1x2 hub to hold location. Also found 60d spike driven in old road 3.97 N and 10.5± E of M+L (Possible Joh Ken point) (Salem Corn SW 13

10-31-85, ¼ Cor 13-24: Set 5' telspar with cast iron cap as the corner. Drove survey marker sign & post 1.0 South Corner set N-S at double the distance from the iron at the Center 13 (set 1977 when stake found) over

the N-S location of the stake ⊢s (by stone) at the 1/16 South of the Center 13 and set on line from the N 1/4 Cr 13 over the iron at the Center 13. Said line comes .26 E of the stake found at the 1/16 South of the Center 13. Corner comes 2 1/2' South of the fence running East a 9' West of the center of the old road (3' from the W. edge of road).

comes 2.99 N & 2.17 E. of MHL using Ferris SW 13

RP's: Spike and CSD in SW side of 11" Burr Oak SE 38.07

10-30-1985, 1/16 North: Leg on line from N 1/4 Cr 13 over the Center 13 and at C. Armstrong measure from Center 13. Found stake on NE side 12" x 18" x 23" long boulder 2 1/2' deep in road. Top Center of boulder .5W and .3 So. of stake. Stake 6.39 So & 4.98 West of T.N. set in & rd & in line fe E. Set nail only at road surface over stake.