
8-28-1964 set C I M ones 2"x 12" galv pipe ① just below surface.

Note: Corner Could go East

1/4 corner 15-22 New Haven 108-15

#851504

1-1858 Hunter P48 No 7p & 15 & 22. Cornwell Bodger.

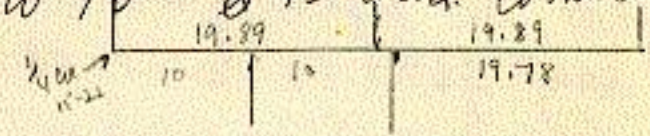

used post or stake

- Meas west 20.00 then 20.00
- Meas east two 10 ch tracts ~~then~~ SE¼ 39.78. or 19.89 M & L.
- Meas south 39.60 to center 22 (2613.6 (1312.74)

= N.E. ¼ = 39.78 = 2625.48

12-1894 Jr Fraser. P556 No 513 & 10-11-14-15, 6 parties. Corner gone. found old elm. with decayed blaze chopped on B T by meas from center R R tracks from old R R notes. (1109)

- set temp point & B Ts - 4" Br Oak N 31¾ E 52L - 6" br Oak N 13½ W 64½ L.
- Meas east 40.24⅝ 3 times to & E 14 ac. & W 14 gone -

- ones -

4-30-1948 J Kerr B37 P23 E cornwell.
run sec line ~~east~~ to west 5276.5'
set corner (1"4 pipe) at 2651 and 17.33 north of direct line.
- meas east 2651.0
- meas west set pipe as 1/16 cor. at 1312.4 then 1313.1 west to set.
Orig record east 2625.48 west 2640. - 5265.48
loops like 1/4 cor 15-22 not set right

visited cor 1977
8-1964 found pipe set C/M over 2"x12" galv pipe.
just below surface. 1½" pipe (up 3') E. of mon. 1 ft.
-60 D in nail & hub west side 14" elm. NE 9.61.
-20 D east side boxelder near base of tree W 4.0
Corner lies under E-W fence - no N-S fence
-16 west ½" pipe 12" up in woods 25.5 north of E-W fence
center blazed. 12" boxelder S.W. 8.1' - 16" boxelder SE 6.0' - 8" cherry N5°W 13.0'

#851504 (2)

¼ Cor. 15-22 New Haven Twp.

Gov. N otes- Cushing, Dept. Sur. 6-12-1854
West on true line between 15 and 22.
40.00 Set quarter section post from which an
Elm 12 in. N51E 71 lks.
Made trench.
80.00 Section corner.