X 10-25-71 set CIM over orig stone and stone. (1)

#851704
10-8-15

1/4 Corner 17-20 New Haven

12-1873 Hunter p235 no 237 & 17 McDonald and others.

Corner gone, in road fill, Mr Kane & Mar Martin. aner
Corner stood at certain spot near wagon track. on
their testimony set stone 2 x 3 x 21. do corner.
Corner came. 5½ lks south & direct line and. 7 lks
east & midway 3.63 4.62 - meas north 39.94. 2B 36. N 40° W.
- meas east 39.64½ (2616.57 S 89° 15 W
- meas west 39.78½ (2625.81 S. 89° 25 W.

3-1892. 2 lks Fraser p473 no 452 & 18 Kennedy Denais Kane.
found stone set by Hunter.

- over.

16 west set stake N & L. ½ 39.89 2/3. (2633.2'
for half mile or (1316.6'

1960s Farmer Herb Raw on town board and owns land on west side both N & S of corner dug with members of town board & found stone, claimed it lined with fence north and in center graded road. Grade at this point from 4' to 8' depending on old grade. Maybe 12' ha ha Herb

---

10-21-71. Meas from C/M at 16-17-20-21 meat, set nail in center road in line fence north at 2616.57. R 2616.57
- no 1/16 fences between - found 1/16 fences meat. varied 3.5'

10-25-71 dug for corner. found exact recorded 2 x 3 x 21 ± stone top down 3.2' only. with small elc fence angle post by rd and large wood stub
Lee card 2.

Card # 2 1/4 17-20 New Haven 108-15

#851704 (2)

10-25-71 Con't.


set CIM over stone and metal objects etc.

Meas now east to CIM 2614.57 = 2614.94 elec. R 2616.57.

Meas now West to iron shaft found (Thos Fraser). 3-1892

2625.8 + 2.0 + 7.45 = 2635.25 2635.09 elec. R 2625.8

Alignment ℄ corner very near record.

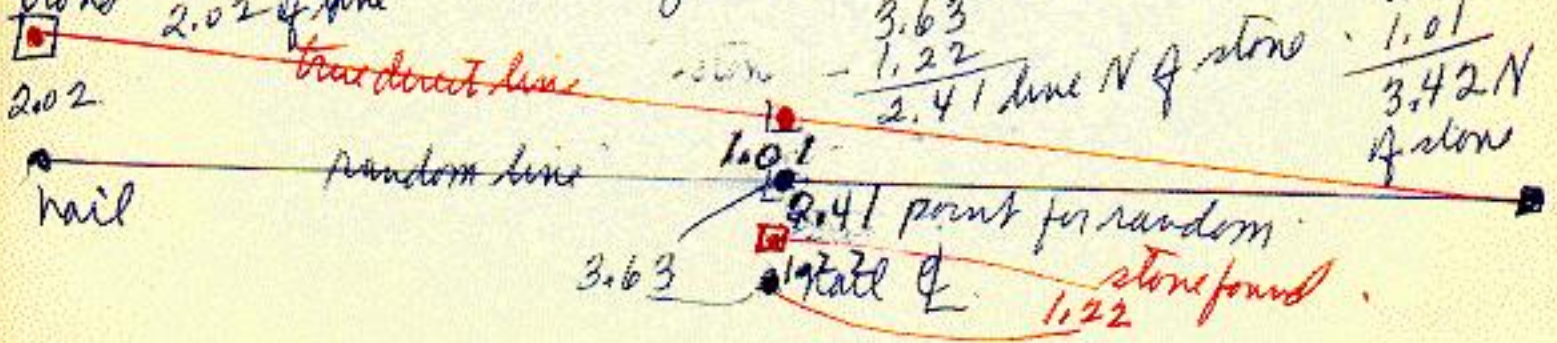

RP 1/4 17-20 New Haven 108-15.

120.2 WNW To pipe cap on S side unmarked power pole.

70.0 2' W & N to 5/8" x 22" rung rod. 4' E & wooden wire fence. driven near flush under fence

corner in center road. 2' east of fence running north.

Gov. Notes Cushing, Dept. Sur. 6-12-1854
West on true line between 17 and 20.
40.00 Set quarter section post.
Raised mound with trench and drove charred stake
80.00 Section corner.

Sept. 1856 Thos. Hunter Pg. 16 No. 26 Shows 1/4 Post
1/16 west 19.95 chs. M & L