L 6-27-72 set CIM at point set 10-25-71 (1)
section corner 17-18-19-20 New Haven 10 8-15-
12-1873 Hunter P235 no 237 S17 McDonald & others
found part of stake in mound drone stake 2' #851705
long flush with surface.
- Meas east 39.78½ (2625.8

3-1892 2 hos Fraser P471 no 452 S18 Pat Kennedy
D Kane & others
corner gone, no evidence as road in cut.
used Hunter's old records. short 10 lks east to S¼ 17.
long 6 lks west to S¼ 18 set at 39.89⅔ from stone at ¼ 17-20
2633.18.
- Meas SE 19 north To ¼ 17-18 2632.4 (39.88½)
- set iron stake as corner. 14" J Oak N50¼E 63 lks
- over.

-16 north drove iron stake N & L 19.94 13/18 1316.3'
-16 west set stake N & L. 20.02 5/16
12" J Oak. S 44½ E 47½ L.
RP 16 north 8" elm. N 76° E 66½ lks.

1939 Co Hwy Dept. B100 P2 found stone mon, no iron mon.
Power pole · NW 39.95 - brace pole power pole · SW 58.59

12-4-69. no discs in any power poles - PP NW has disc on exact south side indicating pole could have been moved, distance could be very close - no dip in road grade. additional info from Co field books. B100 NE cor Kennedy tombstone foundation.
NW 65.6 — sp top C P SW 40.3 - Sp T P SE 59.7 - Sp T P NE 39.2.
Meas south. 2633.8 - north 2635.6 R both 2632.4
- Meas North B 191 2635.7
- Cemetery ded. 1904 231' West 233' N with equal amt north in 1916.


Card #2. Sec cor 17-18-19-20 N. Haven 108-15 (2)
Const. 1939 CHD B100 P2. stone mon. Sta 26+33.8
Corner is PI Δ 0° 29' lt. going north. #851705
NE corner. Kennedy lombaton footing NW 65.6
Sp in top corner F. P. SW 40.3
Sp tel pole SE 59.7.
Sp " " NE 39.2

topo fence corner. 25' left	26+03.0
Corner cemetery fence. 22' left	26+62.0
Center cemetery entrance left	27+79.0
Corner cemetery fence. 17' left.	28+90.0

Cemetery ded. 213' west. – 233' north 1904 + addition 233' north 1916

Co HD B 191 P 3 1951-52. Corner not rec. (assumed) boundary survey.
Corner used as P.I. Sta 76 + 59.55 Δ 0° 30' lt going N.
Meas south ¼ corner or PI 2635.72 B100 survey 2633.8
RPS. disc in PP NW 39.95. – Disc in brace pole SW 58.57
Meas north 5273.75 to sec cor. 7-8-17-18
SE "picket fence" corner cemetery = 76+96.0 – lt 25.0
Gov't Notes Cushing 1854 Rp's disc in P.P. NW 39.95'
disc in P.P. SW 58.57'
~~[illegible]~~

80.00 Set corner to set 17, 18, 19, 20
rock mound with iron stake driven
Oak, aspen, plum, cherry, apple in area

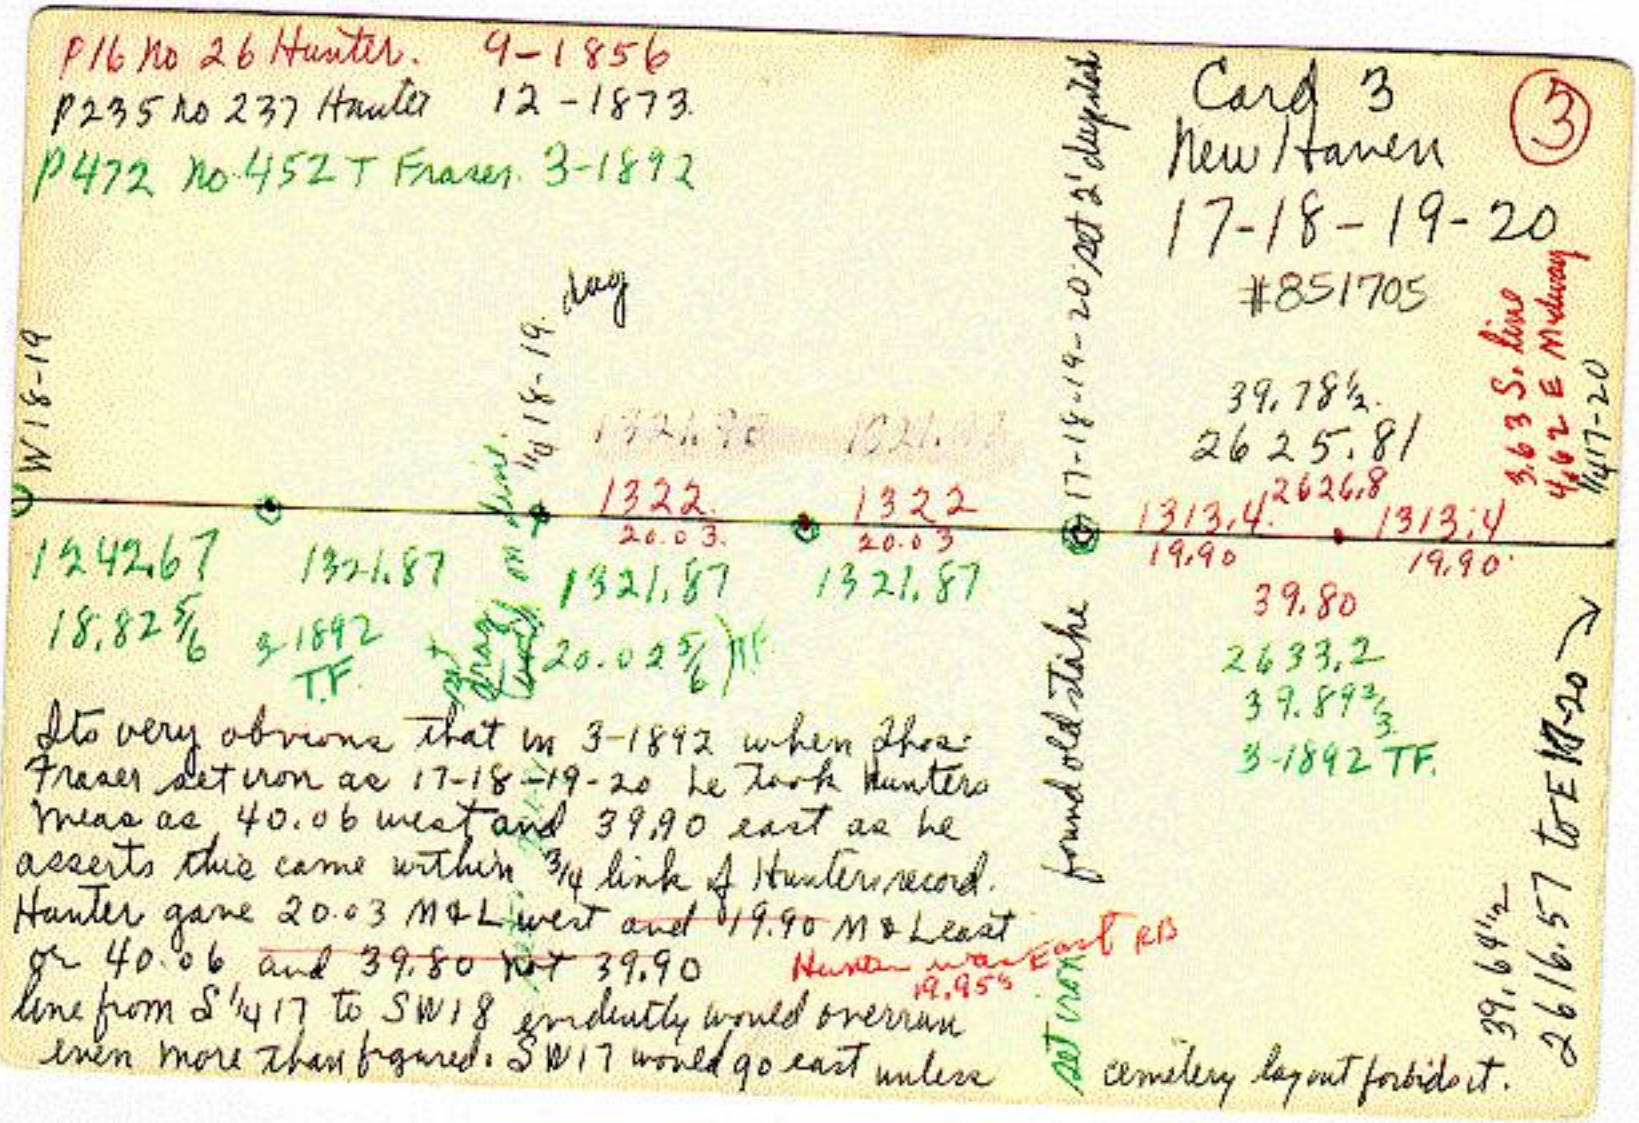

Ito very obvious that in 3-1892 when Thos Fraser set iron at 17-18-19-20 he took Hunters mean as 40.06 west and 39.90 east as he asserts this came within ¾ link of Hunters record. Hunter gave 20.03 M&L west ~~and 19.90~~ M&Least or 40.06 ~~and 39.80 not 39.90~~ line from S¼17 to SW18 evidently would overrun even more than figured. SW17 would go east unless

10-25-71 Co surv. Meas all 4 directions. dug with tractor 15' E&W 4' N&S. found no Hunter stake.
- found iron shaft set by Thos Fraser, & large L stone 4X10X20 lying flat N&S on E side & Cone with ½" rod with blue crayon stub on it all together. Used large iron shaft as Cor.
Meas south to C/M over L Stone & drag bolt set by Thos Fraser 3-1893 2633.45 2633.28 elec. R 2632.4
Meas north to line fence east 2634.3 R 2632.4
Meas north to C/M over W Fraser iron & stones 5267.05 R ?
Meas east to C/M over L stone set by Hunter & used by T. Fraser 2635.25 R Hunter 2625.8 R T Fraser 2633.2
- set 20 D nail over iron shaft - final R PS.
46.45 NW to ⊙ on near bottom NE side Cem. Cor. post
58.50 SW to bard nail in SE side unmarked PP. corner near center cross roads.

(4)

Section Corner 17-18-19-20 New Haven 108-15

Sept, 1856 Thos. Hunter Pg. 16 No. 26 Shows Sec. Cor.

1/16 West 20.03 chs. m&L - B.T.'s (S 61½° E 91 Ks) (S 50½° W 1½ Ks)

1/16 East 19.95 chs m&L to 1/4 Post.

#851705

Note: This Corner probably not at location found by T. Hunter in 1873 and is more likely to be T. Fraser 1892 location. RWB

T.H. Corner at least 10' farther East