X 8/7/89 C.H.D. SET 5/8" BRASS PLUG #8519060


1/4 corner west 1/4 19 New Haven 108-15.
1-1896 Fraser P 589 No 535 west line W 1/4 18 to W 1/4 30
Corner gone - set iron stake M & L 39.59 1/2 (2613.3
on sections corners set up & located.
-16 north set iron rod M & L 19.79 1/4 (1306.65'
-16 south set iron rod M & L 19.79 1/4 (1306.65'

Co Hwy Dept. B 191, Sta 0+00.
found iron drag torch evidently P 589
Disc on fence post NE 5.05 could be SE
Disc power pole. SE 44.1 " " SW
These distances direction assumed by placing of notes in field book.
(over

P.I. east at 1734.35 - Dec 8" ash NE 39.3 - Cmd to NE same direction
Dec 10" maple SE 37.4 dope as corner. Cmd to SW

Δ 0° 28' rt going east.

10-28-1971 Co surv set nail at W¼ 30 in line fence east and 8' to 10' S of ℄ road west into Dodge County. R 2613.3 per ½ mile.

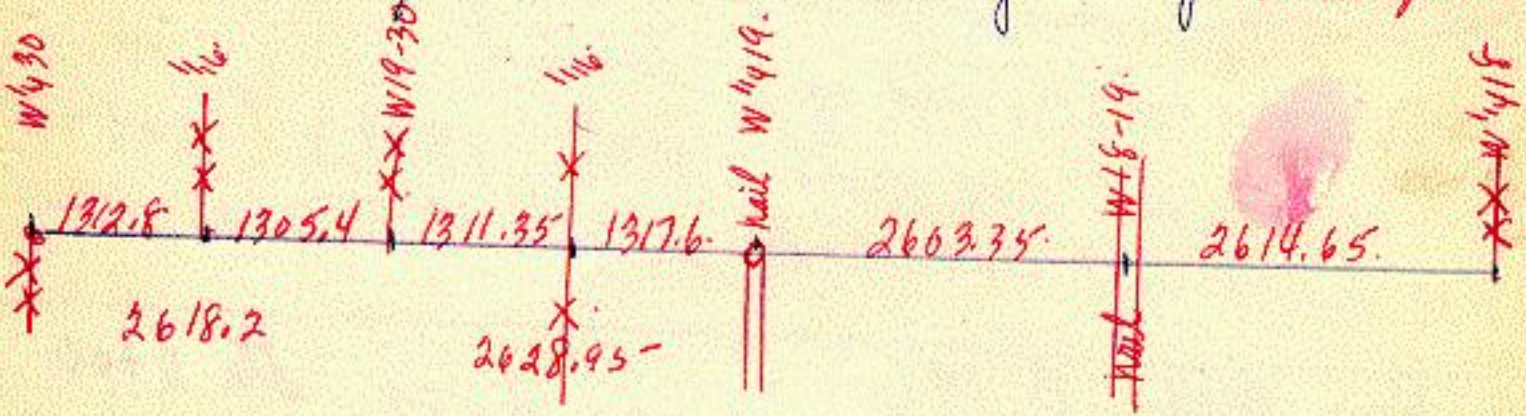

#851906 (2)

W. ¼ Cor. 19 New Haven Twp.

Oct. 1853 Gov. Notes- Ball, Dept. Sur.
North between sections 19 and 24.
40.00 Set quarter section post.
Blk. Oak 8 in. N56E12 lks.
Blk. Oak 10 in, N51W 25 lks.

5-13-1980 1/16th North (1980 Remon BK P.31)
Dug for Will Fraser's iron with backhoe centered over traverse nail over dip. Found 5/8" bolt with 1¼" square head bent over 4.3 deep .92 South and .60 West of the traverse nail. The top of the bolt was bent North but the bottom was standing straight. The iron was ——— West of ℄ N-S road.
T.N. 4.38 E 6.45 S Bolt 4.94 E 5.51 S

5-13-80 1/16 South (1980 Remon BK P.31) Took difference from Will Fraser's iron (a 5/8" rod found 5.4 deep

5-9-1980) to traverse nail. Said iron 2.45 South and 5.3 West of the traverse nail

5-16-1980 (1980 Remon. BK. Page 36) W 1/4 Cor 19: Dug with backhoe. Found 5/8" bolt with 1" sq. head 5' deep 16.5 South and 7.2 West (these eyeball not to accurate) of the traverse nail. Set a 5/8" rod at the road surface. LRP's 4.98N 3.98E

5-27-1980 W 1/4 Cor 19 (1980 Remon. Bk Page 43) Set a 1/2" x 18" rod on line from the West 1/4 Cor 30 to West 18-19 and at prorated W.F. measure as per survey No. 535. Corner came .22 North and .04 East of the 5/8 iron (removed) set over W.F. bolt 5-16-1980. This corner 7.5 West of the present f.

RP's CSD SE side pp # 23235 in yard SW 86.42
NE corner (conc. block fdtn) of addition to Metal shed NW 118.95
NE corner (conc. fdtn) of corn crib NW 103.25 (slope)

1/4 Corner W 1/4 Cor 19 New Haven 108-15 ③
#851906

7-16-85, W 1/4 Cor 19: Corner may be destroyed by road construction. Set 5/8" Re-rod 1.0 South of a wood fence post in fence line running East (fence 30½' North of corner.

π @ 5/8" rod meas. to W 1/4 Cor 19 (½" re-rod) = 101.68

∠ Rt W 1/4 Cor 19 to W 1/4 pole of pair in N-S transmission line 1/4 mile ± E of County line and NE 1/4 of 5/8" rod = 159° 53' 32"

Additional RP's: Small nail in N 1/4 side 24" Burr Oak West NW 87.13

CSD in pp 23235 (old tie) SW 86.36

8/7/89 C.H.D. SET 5/8" BRASS PLUG IN E C.R. #5
RP.
CHD. DISC IN P.P. WSW 49.44'