K 9- 1973. set 1/2" x 30" pipe from west and N-S section line. (1)

#852106

1/4 Corner 20-21 New Haven. 10 8-15.

12- 1871 Perry by Hunter P189 no 200 Donahue & Brown. S21.

found 1/4 post standing, chiseled B tree. standing.

-16 north set stake Mol 20 00 took 2 Jouk B trees.

T.H. Fd BK 14 p.8 6-1883 - SE. 1/4 Sec. 21 Not much data

8-1922 J Kerr B-9 1920 to 22 P18. total 5262.7

run section line. 26 31.35 5262.7 set tube at 1320 - 2640 - 3960

random line fell 39.7 W/4 corner?

set some kind of point midway to run west 2631.3 to Center 21.

room line west of 2631.3 set 1320 found 43 N/4 stone at center 21.

Perry set woodlots some still lines east 5.01 - 15.02 - 10.01 - 10.01. 1/16 north at drone stake bar down 1/2 stone at center Sec 21

(over)

10-1969. drove to corner with Perk Higham. ground dry and hard. searched some for corner. stake abandoned. search. Authentic stones found at 1/4 19-20 and center 20. Could enters projected line from west and N-S section line. -sure would be a chore, woodsy, rough. (elec. Trav. was easy.

9-1973 County Surv.

Set 1/2"x30"± pipe at this 1/4 Cor. by projecting line from West - W.1/4 Cor. 20 over L.S. at Center 20 and by running N-S Sec. line (both lines by elec. Traverse). This placed Corner under N-S fence but 12' North of fence running West. Also found J. Kerr's 1922 1/4 Cor. - a 3/4" bolt which we removed bolt was 2.87' So. & 0.3' E. of our Corner. Kerr's Corner was supposed To have been set M.+L. but was about 4' So. of Midway.

R.P.'s - nail in Top of Cor. fe. post - South. - 12.1

30p Spike in 12" elm Tree - N.N.W. - 36,0

Meas. North 2621.34 - South 2618.33

(2)

¼ cor. 20-21 New Haven Twp.
#852106

Gov. Notes- Cushing, Dept. Sur. 6-12-1854.
North between sections 20 and 21.
40.00 Set quarter section post.
Br. 5 in, S46E 161 lks.
Made trench.

10-21-81
Note; This Pleasant Grove Twp
T. Fraser Field Book 8 p. 10 #1892 Sec. 21-108-15
Set stake midway ✝ Line ("C" To "E" section corners N&S)
Took B.T. N48°E 5 3/4 lks. 6" Black or Burr oak


T. Fraser Fd Book 7 p. 28-30 Survey of Road in Sec. 21-22

1/16 North of ¼ Cn 20-21 10-22-81: Dug from e.p. (ton. on NW side) to fences E. and S. for 4' West and 4' South. Found one mark that could have been a stake mark 1.45 West and 2.7 South of the ton

t.n {NE 1.37 / NW 2.37 mark {4.26 NE / 4.32 NW

10-23-81 ¼ Cn 20-21: Dug from a point 6½' South of the pipe set in 1973 as follows:

Found a pointed boulder 22" long and 10" x 12" at its widest point. Found a stake mark beneath the stone extending well into clay. Drove a 1" sq. pipe/cap in the stake ~~hole~~ mark and set the stone on the South side.

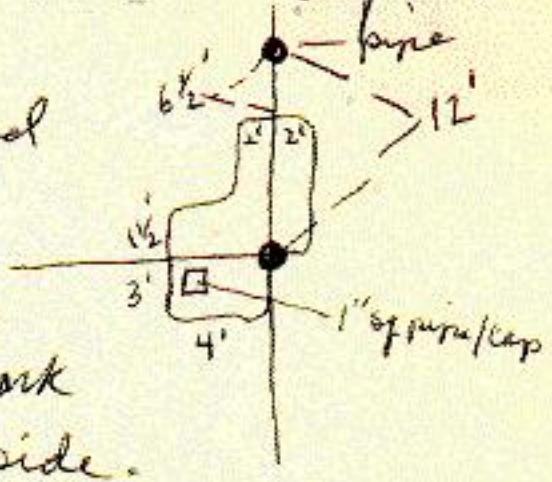

This corner 3.5 West and 13.28 South of the ½" pipe.

RP's Spike in NW side c.p. ENE 3.3

Spike in SW side brace post SE 6.4