
1 12-4-69 set CIM over 1"x21" axle stake, stones & glass W & N.
section corner. 21-22-27-28 New Haven 108-15
12-1913 D Williams P250 B SE 40 & SE¼ 21
found section corner and 1/16 corner north and
apparently the S¼ 21. no descriptions. lad out road
(1) #852205

A-B-C stakes.

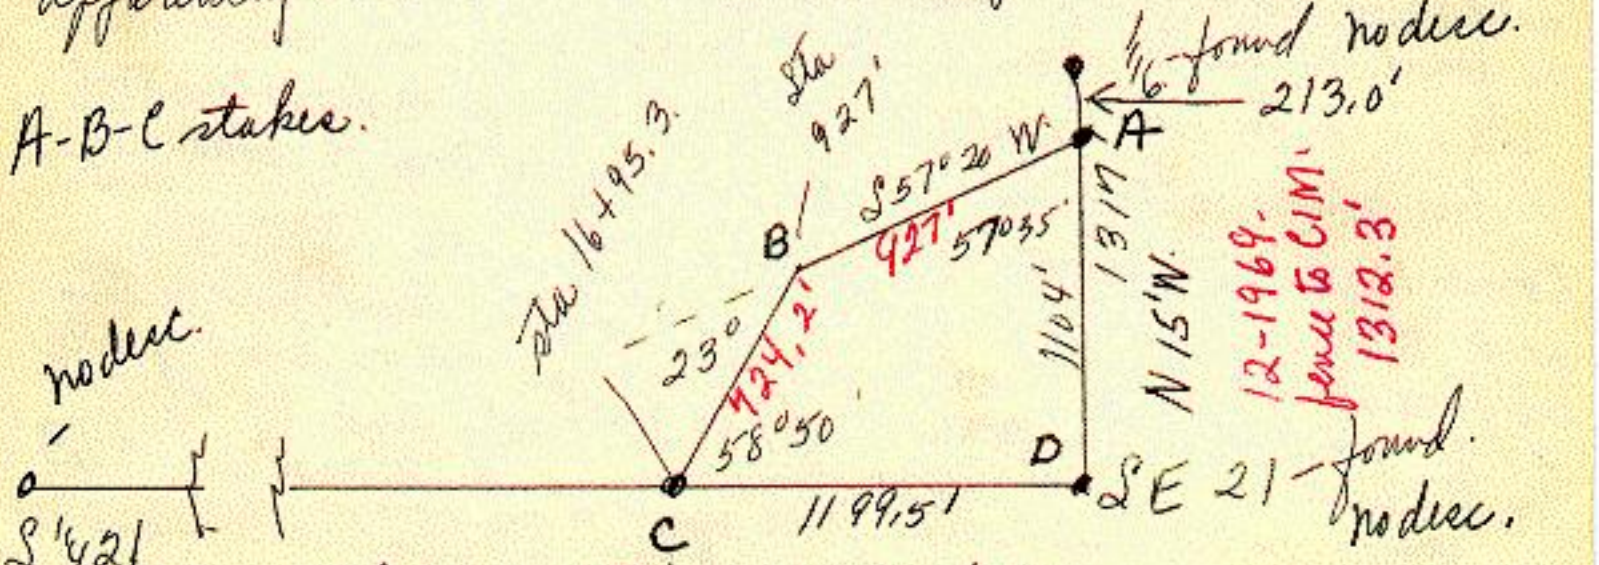

set line stakes from C to ¼ corner. no dec.

Cover

12-4-69. J Kerr. meas from 1/16 fence East and west south 1317' carefully. also projected line from SW cor 21 over rod set by Perk Hyham Dodge Co surveyor an assumed corner on 40' ⓢ north. found stone at SE 21 offset digging hole 6'x8' east of fence on trees as line of fence south across creek indicated it might be east - common land. so fence no factor. found stone 10x40x18 blue granite with cross 4'x6'x18 on top tipped over by tree roots. no other stones in entire area. stone lies 1' north scraggly turn 18" boxelder in roots. Corner came at about 4.7' north of 1317 or 1312.3 and 37.3 south of 40' ⓢ or 2.7' north of true line calling shifting of Hyham rod. 1.35' north of corner on line originally. 20 D nail 12" tree (could be ash) on north edge creek up 4' 12' east of S. 493' 20 D nail in 13" wire wrapped elm in fence north east side tree up 4' N 22.15' old nail in top old corner post south. 36.25' steel fence post up 3' west .5' at junc of carlen staff 1"x21" below C/M (junc of old stone above & W+K C/M)

New Hamm Station corner 21-22-27-28 #852205 12
Cast Metal marking 1854
Bore set 2 ft. to post to section 21-22-27-28
mound with trench, no previous instrument. stone
charred stake

5-15-79 Shot CIM For C.H.D.

May, 1863 P.C. Compton Rg. 10 No. 99 shows see Corner
(See Survey for Interior of Sec 28