Sec. Cor 22-23-26-27 New Haven 108-15 ①

Gov't Notes: John M. Cushing, Deputy Surveyor 1854 AT 80 chs Set Corner of Section 22-23-26-27 raised Mound with Trench as per Instructions & Drove Charred Stake

#852305

May 1857 T. Hunter - Town of New Haven Survey shows Stone @ S W Cor Sec 23

1972 Tom Ferguson Set ½" Iron as Corner by Doubling his Corners at ¼ Cor 23-26 over Iron @ fence Corner @ 1/16th West of ¼ Cor being 1328-1328

12-1973 Co. Surveyor fd Stake & Set CIM @ ¼ Cor 23-26 .44' s of & .195' west of T. Ferguson Cor.

June 1978 we Traversed the North line of the NW 1/4 of Sec 26 & Adjusted the sec cor to be 1.64' North and .17' west of T. Ferguson Iron location

August 1986 Co. Surveyor was working in Section 22. Measurements & Recorded Stone lead us to dig with back hoe we fd Stone 4.39' North & 17.93' East of T. Ferguson Iron location

See Card (2) for dig Info

SEC COR 22-23-26-27 NEW HAVEN (2)

#852305

SE c cor. 22-23-26-27

ditch between RR (now DNR trail) and C.R 3.

RP's:

Spike and CSD in NW side
6" Box Elder ENE 9.93


Spike and CSD in NE side
11" Box Elder NNW 14.63

Locals to T.F.& 1/2" rebar (removed)
Nail in E'ly Edge B.T. on Trail
SW 12.99

Nail in E'ly Edge B.T. on Trail
NW 16.25

See Cor. 22-23-26-27, New Haven
8/20; 21/1986

Dug for corner as follows with back hoe:

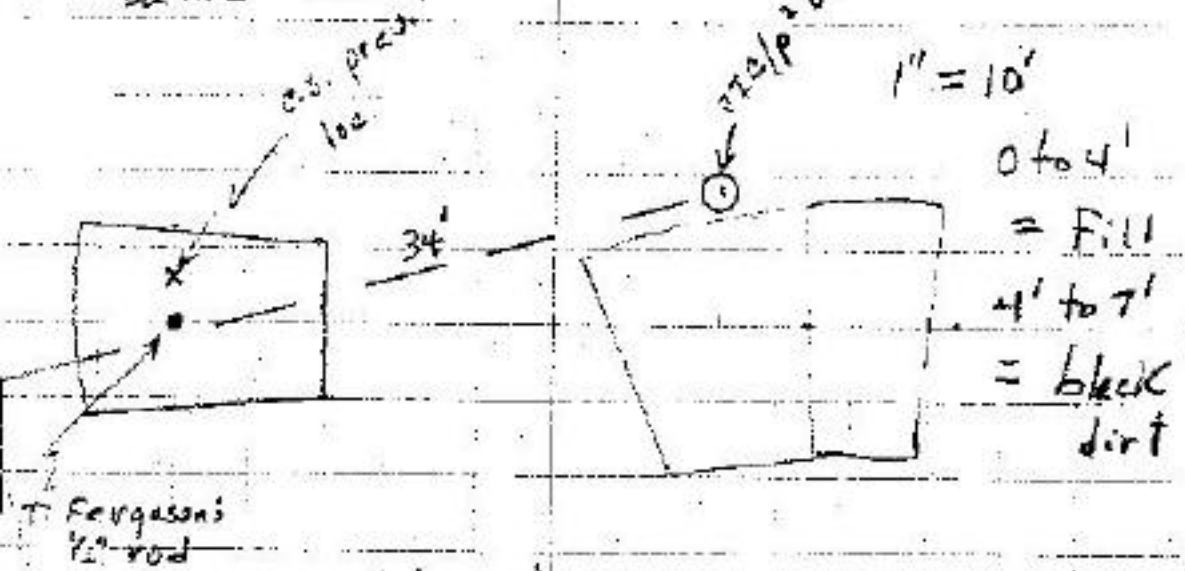

Hit stone with probe in North wall of hole Stone 3"x15" top and 6"x6" bottom by 15" long. Top down 4". No evidence of stake. Put steel fence post stub & Flat iron by stone. Set CIC/p² over stone and survey marker sign & post 1' North Corner 34' (F'ly) at right ∠'s to ℄ old RR bed and in