K 11-13-69 set C/M over 1"x22" and orig stones & junk found 4' 1" rod and 1"x22" pipe (1)


#B52306

1/4 Corner 22-23 New Haven 108-15

12-1894 H Fraser P558 No513 d 10-11-14-15 6 parties. found stone set as corner by Co surveyor in years past at corner & fence left as found.
- Meas North. 39.78 (2625.48'
used to set section corner north.

4-1948 J Kerr B37 P23 E. Cornell. d 22.
found corner run 1/4 line meet set Center 22.
- Meas meet To Center 2618. - record 1857. P48 no To 3966
2617.56
Corner is pipe in garden - no references.

- over -

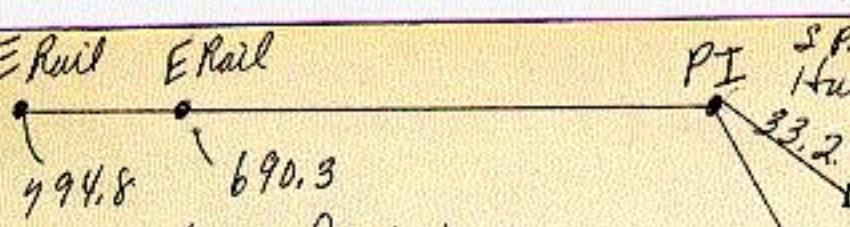

Co Hwy Dept notes.

11-13-69. found 4' rod with 1" x 23" pipe around it and 23 pieces of stone and 3 pieces of gas pipe fittings after at least 4 full days over 3 year period of work and search. - came in garden as in survey 1947 when no references were taken. - run and meas line from center 22 east - corrected told 2620.3 1948 2618.1 set point on random west of old abandoned rail bed at 1926.7 which would go 23.59 north. - run & meas line from C/M at NE cor 22. south set points on line at various offsets - had to triangulate over swamp. a rough, brushy peat-swampy line. Corrected meas. 2624.2. W Fraser record 2625.5

see Card # 2.

#852306 (2)

Card no 2. 1/4 22-23 New Haven 108-15

County notes call for 19°10' from tangent line west south 33.2' - a near exact reproduction of PI as to line and measure from bridge shows 36°35' at 24.9'
- set 3/4 length C/M over 1"x22" reinf. bar with top of C/M 12" below ground. with much glass and all stone pieces arround C/M base. small bottle with notch on west side 6" down from top of C/M.

---

on random from Center 22 east set nail at 1926.7 m
old nail tied. Missed corner. 32.08 south 2.45 E or 2615.55'
correction at 1926.7 north 23.59 - 1204-69 set 5/8"x6" rod in place
of nail (stone ledge). hard nail in PP 23719 L. 17.83
- hard nail in center of 3 tele cable poles (overhead cable) west 59.6.
ones for RPs.

Center gas pump - or air pipe on west side	NNE	90.2
Center "4" filler pipe west of pump where it enters ground	"	85.0
SW corner house lean-to part	NNE	133.0
- west side of house on exact line toward corner.		
center large 30" elm (center root splits west)	NNE	75.3
Center 28" burroak 3rd tree north	"	162.0
hooked boat spike on N side 48" elm	WNW	71.6
PK on S side power pole # 23688	SE	121.75

6-78 Set a survey marker sign and post 1' North of the CIM

Govt Notes (cont. 1854)
40.00 set 1/4 sec. post from which
oak 13 N 20 E 21 S made from 9 138.6 Ct

Twp, 1858 T. Hunter Pg. 48 No 10 shows 1/4 Post, Prop Cor West 9.66, then 10 chs. then 10 chs, to CEN sec.