/ ~~11-10-71 set 3/4" x 3' pipe as corner~~ #853205 (1)

5-9-79 Set CIM.

section corner south 31-32 New Haven 108-15

North 5-6 Kalmar 107-15

6-1910 Ch. Larsen P128 B L32 Ward, Blake, Prentice

found stone (set by former survey)

- 1/16 north. plat shows corner 19.97 (1318.0'

likely used for line east.

2-1870 R Perry P98 no 140. L6. C Kutzler.

found post standing - 2 B trees standing - 2 BT stumps.

checked & found correct

- west 40 (2640' to post and stone found. then 39.22 to twp cor. (boulder. B trees touch NW corner boulder (old-fake rob.

Govt meas 3.9.50. left N 1/16 to NE 6 as found 2640'
set oak post as 1/16 corner at 19.86 1310.76 then
19.36 (1277.76 To Twp cor

4-12-71 Co surv. meas east from township corner. ~~C I M likely set by Park Higham~~ No Good - Ed Twp Stone 7' W, found 1/16 fence running north (new) at 1281.25. R Perry. 1277.76

- found pasture boulder stone just SE of corner post of fence south. - ground frozen hard below top of stone. believed true cor.

meas from C I M. 2573.0 R 2588.52. or

C I M to 1/16 1277.76 1/16 to 1/4 stone 1310.76
act 1281.25 1291.75'

Cont line and meas east from 1/4 stone 5313.2 to 1/4 stone at S 1/4 32, N 1/4 5. - line from twsp corner over 1/4 Stone at S 1/4 31 projected east to S 1/4 32. would fall 10.35 South of S 1/4 32.

Card # 2. South 31-32 New Haven 108-15 (2)
North 5-6 Kalmar 107-15
#853205


4-12-71. set small rod on direct line from twsp Corner over boulder at S 1/4 31 and midway between S 1/4 31 and S 1/4 32 5313.2 total or 2656.6

- 1/16. fence west (N & S) would be 1328.3 to be midway. actually very close. (about 1327.5 1/4 stone east.

- fence corner at 1/16. may be 1 foot or so. south of line over 1/4 corner. Offset data twsp cor N 10.0 1/4 cor N 11.15 1/16 13.0

11-10-71. Co surv. dug with tractor 3' east of rod (north & south 3' each way.) west at least 15 or 20 feet found only large boulder found 4-71 in upper fill doubtful of corner. west and south of corner set too much to mean anything over

reset corner as formerly set. with . 3/4" x 3' pipe.
no favorable references at hand.

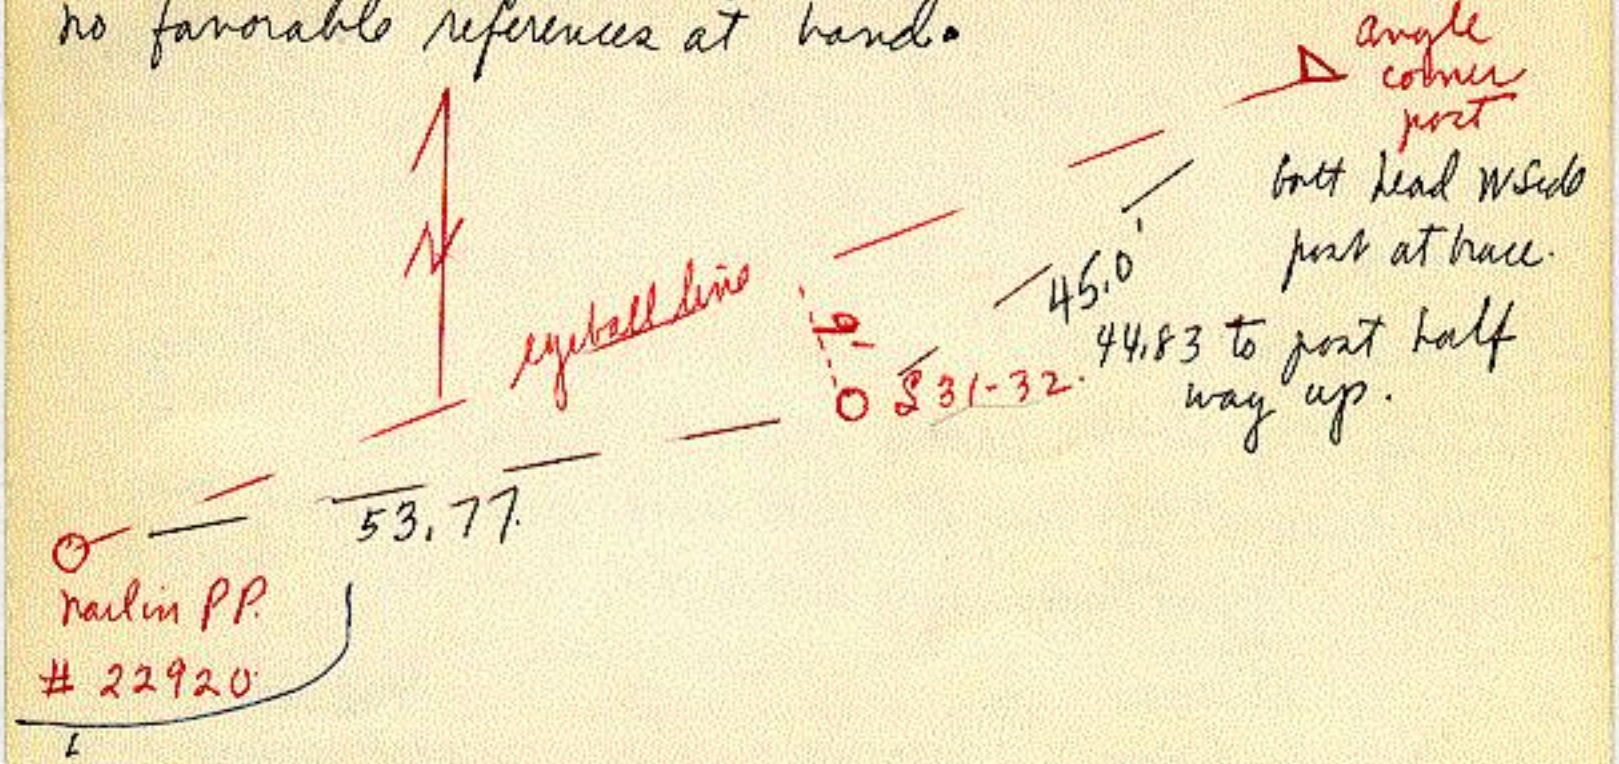

Section Corner South 31-32 New Haven 108-15
4-14-79 North 5-6 Kalmar 107-15
#853205 (3)
1/16th West (1979 Renomumentation Book Page 19)

We dug here from the traverse nail North 2', South 3', West 1', and East 2' by 2' deep into clay. We found only two small post stubs 1½' North of the traverse nail. The N-S fence here is much older than the present fence West and appears to have passed through this point having no corner post. The fence from the West terminates at a new corner post 1' West of the N-S fence. We studied the land ownership around this corner. See Ownership file and Remon. Book for information.

At S. Sec. Cr. 31-32: Set a CIM over a ½" x 18" iron on line from the SW Cr 31 over the mark found at the 1/16th East and at Perry's prorated measure (prorated against Perry's measure from SW 31 to 1/16th S) 5-9-79
The corner is 1.68 North and 10.14 West of the pipe set in 1971. (remains) The corner is 5' East & of rd. North and in & of the rd. East and in on the SW side slope of the road in the curve to the North and East. It is 34' SW of the center of the road on the curve.
RP's: CSD in NW side pp# 22920 (up 6') SW 46.80
& iron corner post NE 50.3
We set a survey marker sign and post 1' So.

Section corner South 31-32 New Haven 108-15 (4)

North 5-6 Kalmar 107-15

#853205

Govt Notes

80.00 Set post corner to 5-6-31-32

Black Oak 10 N 75° W 27

" " 10 N 11° E 100

" " 14 D 1½° W 61

" " 12 D 1° E 60