X

#8533091

1

1/4 Corner Center 33 New Haven 108-15
12-1897 Pr Fraser P614 No 558 S33 Saltman, A. Hurd
found remains of old stake set P 18 No 30, D. Pierce.
and stump NW BT. On running intero lines found
corner on E-W 1/4 line but 10 lks (6.6' Too far east Quite
to be on direct N-S 1/4 line.
- set new stake with stone by side.
-16 west set stake M & L 9.85 (1310.1'
-16 south. " " " 20.00.
- north set stake at 9.94 (656.04' then 9.94 to
1/16 stake set M & L 1312.08

-over.

east stakes at 4.93 (325.38' then 9.85 (650.1' then 4.93 (325.38' (overlap) then 10.85 (716.10' then 4.95 (326.7' then 4.95 (326.7 to 1/4 33-34 (a c I M) (See Card #2)

Only way accurate mean center to E 1/4 33 is mean it & run entire E-W 1/4 line

12-1916 D Williams by J Kerr P 264 B 2 E 1/4 & 33. found stone as recorded. 2643.4 from S 1/4 33 to Center 33 -16 south stake at 1321.7. for line east to 1/16 stone betw 1/4 33-34 and S 33-34 mean 2604.5 with stone set 651.12 west of 1/16 S of 1/4 33-34 both found 11-17-1970. mean near 651.0 (Quote 1/4 stone at center Sec 33).

11-1856 Hunter: P 18 B 30 showed corner on 4 B trees. -16 east 19.72 (1301.52) M & L. -16 south 2003 1322.0

B.T.'s (N 79 3/4° E 12 1/2 lks.) (N 41 1/4° W 26 lks.) (S 23 1/2° W 11 lks.) (S 49 3/4° E 15 lks.)

Section Broken in Many Small Tracts see Survey Book A Pg 18 No. 30 Lee Card #2.

Card # 2. Center 33 New Haven 10 8-15. (2)

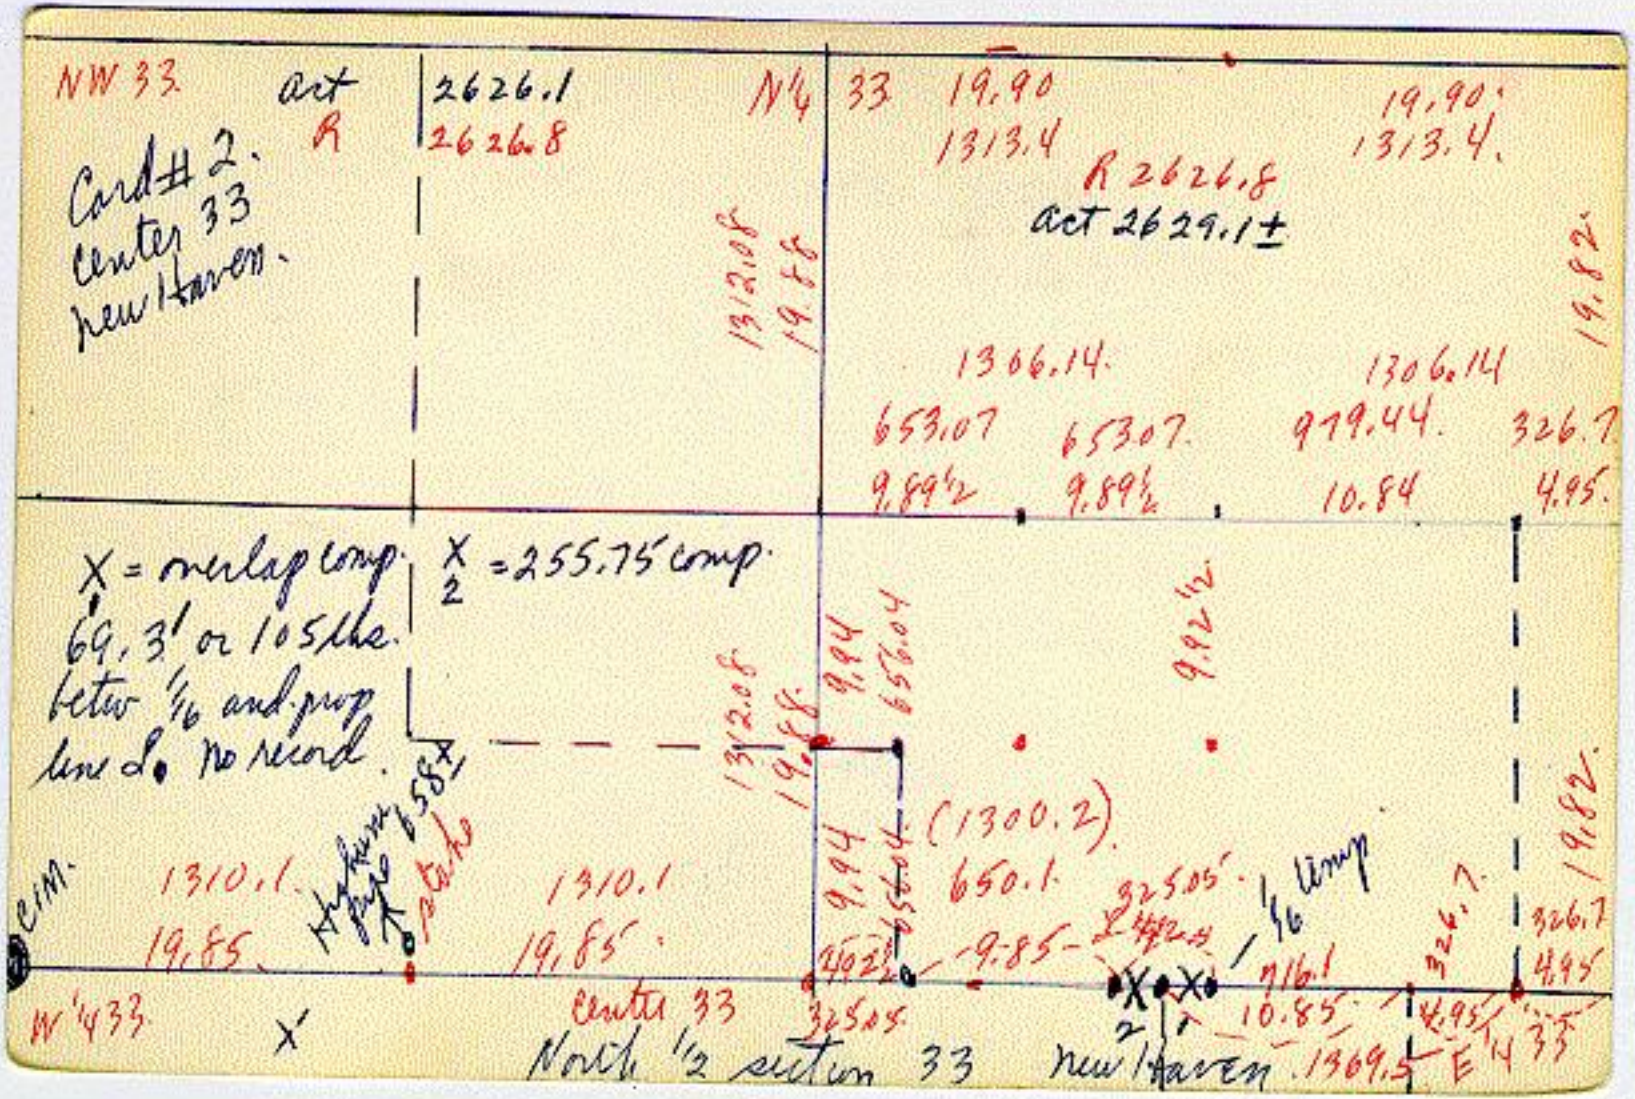
No record of seeing corner since. 12-1916. P 264.5.

- Meas from. stone & C/M at 1/4 32-33 east. #853309
found pipe under fence set by P. Ingham at 658±

- cont meas only east, no definate line south along.
woods. but large corner post at 1310±

To find Center. (Not prop corner N & S. but on E-W prop line)
Meas either from east or west (may not need line.

Feb, 1863 P.C. Compton Pg. 68 No. 95 used Center to split Property in S.W. 1/4 Sec. 33 Does Not Show How Center was set.


NW 33
act
R
2626.1
2626.8
Card #2.
Center 33
New Haven.
N¼ 33
19.90
1313.4
R 2626.8
act 2629.1±
19.90
1313.4
19.82
1306.14
653.07
9.89½
653.07
9.89½
1306.14
979.44
10.84
326.7
4.95
X = overlap comp.
69.3' or 105 lks.
between ⅛ and prop
line L. No record.
X/2 = 255.75' comp.
1312.08
19.88
9.94
653.04
9.92½
1312.08
19.88
9.94
650.4
(1300.2)
650.1
9.85
1310.1
19.85
1310.1
19.85
Hickory
Stake
Stake
Elm.
W ¼ 33
X'
Center 33
North ½ section 33
New Haven
325.05'
⅛ comp
9.85
716.1
10.85
326.7
4.95
1369.5
E ¼ 33