X 11-24-81 Merit Patterson set 1¼" galv. ⌀ iron over stone
4/29/89 Vince Fagnano set 20" ⌀ feldspar in place of stone (1)

1/4 Corner South 1/4 34 New Haven 108-15
North 1/4 3 Kalmar 107-15 #853404

12-1897 Jr Fraser P614 no 558 S 33 J Ottman, found old stake remains and A Hurd, D Pierce stumps of both witness trees, set new stake with stone by its side. - Meas west 39.72 2621.52'

12-1916 D Williams, J. Kerr. P264 B S 33 T Fraser & attorneys. found stone and stake as corner, left as is.

1935 Co H D. found above stone, a L stone 2" x 6" top, 8' north of fence line east in line fence running west, also found stone 552.3 north. bk 78 pgs 10, 74

6-1946 J Kerr B30 P 57 to 59 S 34 J Felt

(over

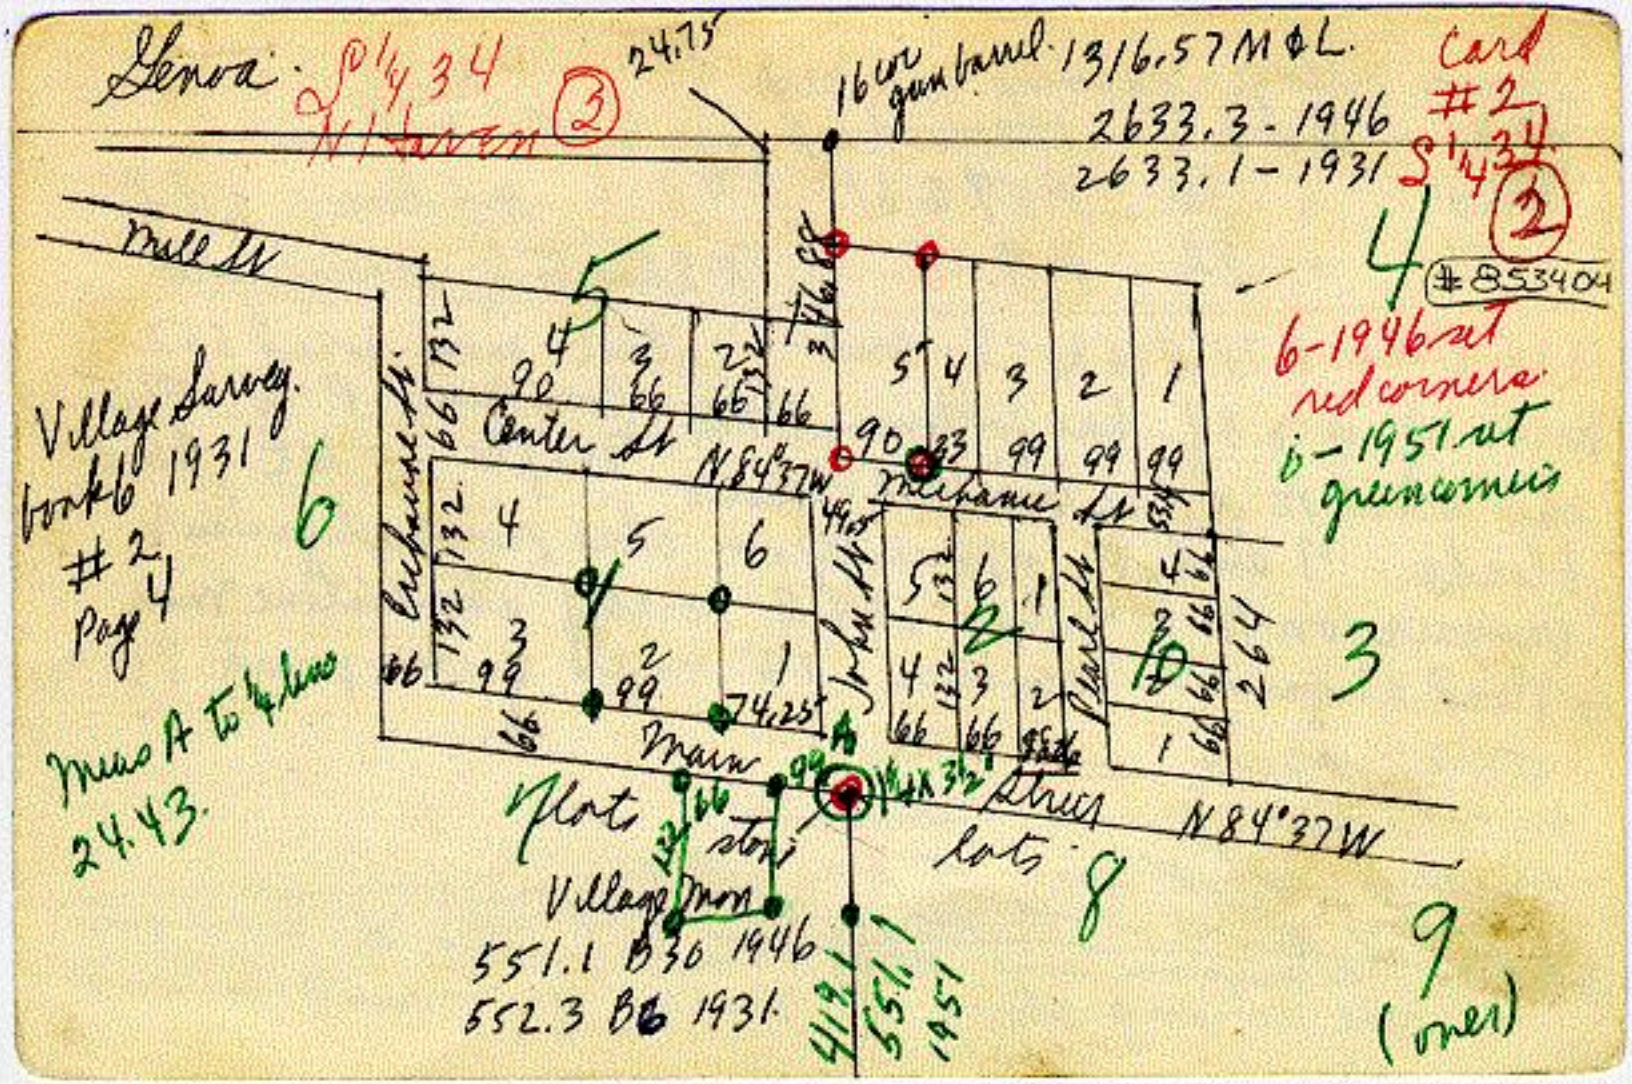
Run line north, found stone, village mon. at 551.1.
- 16N set iron at N edge Lenox Valley Limits.
- Meas N to Center (34) "Corner post in place accepted as Center section (34) - stone once at corner.

1966 J Kerr B 94 P 61.
found stone with ½" iron pipe beside stone.
- Meas west 2334.7 To river bank. E side. (2624)
- Meas south to large Corner post accepted as Center - 3 (fly miles)

12-1970 found 3 corners at S 33-34

J Kerr 1916 P264B	2613.67	W of S¼ 34.	1319.19	S of ¼	stone
J Kerr 1930	2610.47	"	1318.44	"	
W Fraser 19 P614A	2620.33	"	1311.95	"	
	R 2621.52	"	R. 1313.4	"	

measurements from different corners found of S 33-34


Genoa
S 1/4 34
N 1/2 SW 1/4
24.75
16 cor gum bank
1316.57 M & L.
2633.3 - 1946
2633.1 - 1931
Card #2
S 1/4 34
#853404
6-1946 set red corners
6-1951 set green corners
Mill St
Center St
N 84° 37 W
Mechanic St
Main St
Plat of Village lots
N 84° 37 W
Village Survey book 6 1931 #2 Page 4
Meas A To A less 24.43
Village Mon
551.1 B30 1946
552.3 B6 1931
551.1 1951
(over)

Genoa village surveys in or near.
1931 - Book 6 - ~~1931 book #2~~ page 4-5 N-S line
6-1946 " 30 P59 to 61. N-S line & lots.
6-1951 " 52 P 7. N-S line to 1/16 several lots.

1935 CHD B78 P10 & 74 Cont- stone mon found 552.3 North of S 1/4 34 has following RRs. Cor fence P. N 59.5 this stone on S line maintain between Maple. NE 95.0 blocks 7 and 8 apparently. - also road alignment crosses on N-S 1/4 line 194.2 North of above stone mon. - Road alignment crosses 33' north of this point ??

Geo Notes,
1/4 on S-E [illegible]
Hickory 12 N 30 E 50
Hickory 8 S 25 W 10
6-12-1984 V. Jongmon said that Pat put, the X iron on the wrong stone 8' South if correct corner

#853404 (3)

¼ corner South ¼ 34 New Haven 108-15
north ¼ 3 Kalmar 107-15

4-27-89 V. Fangman 24" x 2" telspar / C.I.C. in place of stone

28.53 to 30 D spike in 6" elm south
48.87 to " " " " 8" " southeast
32.97 " " " " " 10" " "
0.5' west & 0.3' north of fence post
8.5' north of fence to east
in line fence to south + west

8-26-93 1/16th North of 5¼ 34

fd 2" pipe leaning westerly very badly reset vertically after digging for further evidence. fd old wood post stub beside Pipe. The pipe is 18" long. Visited 5¼ 34 found CIC/P2 in good Condition.