
(943505) South Sec Cor 34-35, T109N, R14W File with N1/4 2

12-1895 W. Fraser (P586 No. 534) needed to set the N1/4 Cor 2 (1) and N 2-3 but apparently could find no evidence so measured and ran line from N 1-2 (stone set by Hunter (page 359) in place of stake) to N 3-4 (stake by Thomas Fraser in place of Govt stake) and set N 2-3 on line and prorated Govt measure and then N1/4 Cor 2 midway and on line.

Appx 1916: Power Dam Survey: Shows "no stone" at S 34-35 but measure of 657' West from N1/4 Cor 2 (stone) to S 34-35 and straight line from N1/4 Cor 2 to N 2-3 (stone)

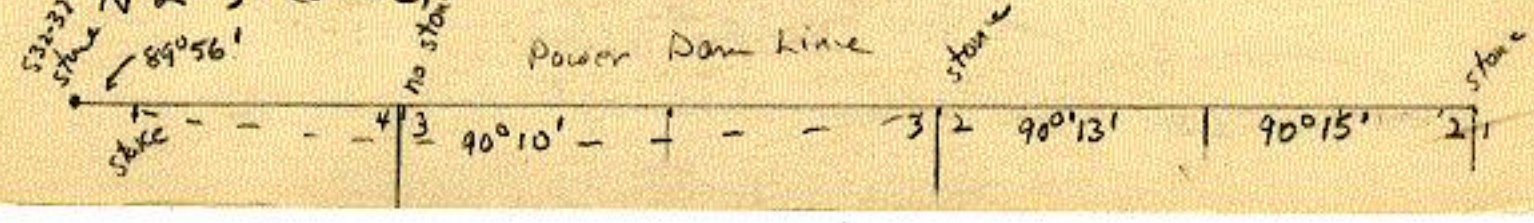

1910 Letter From Rafter to Thomas Fraser states ~~[illegible]~~ corner in Field and Found nothing but pride stones at N1/4 2 and N 2-3

6-1964 John Kerr Fd stone at N1/4 2 } rammed 1965 For grading and reset Fronties

7-1964 " " " " " N1-2

N1/4 2 Card: Measure 657.0 West to CIM set on S. Sec Cor 34-35, T109, R14 (believe this John Kerr Date)

N 2-3 Card: After 1972 survey CIM @ S34-35 "may now be a little North of line"

1925 Kerr BK 25, Page 9 Kerr Finds NEL, N1/4 2, 1/16 W of N1/4 2 and measures this 3/4 mile but does not mention S34-35

8-10-64 Ken Waldorf Book (Page 22) "From N1/4 Cn Sec 2 Rand W. Az 270°13' 657' For Section Corner 34 & 35 — 109-14". Surveying N in Sec. 34


P61: Used corner to survey road into Dream Acres

North line sections 2 and 3 Arroyo.

follow N 2-3

943505


(2)

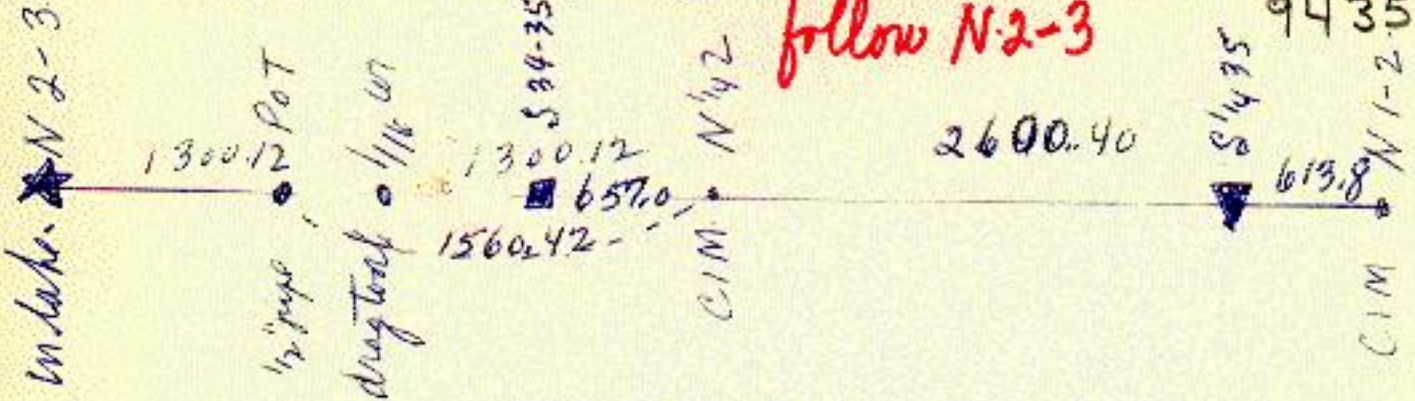

■ S 34-35 Wab Co 657.0 west of N ¼ 2. (may now be little N. of line now.
CIM

▼ S ¼ 35 Wab Co 613.8 west of N 1-2

★ N-2-3 in lake an assumed computed point on direct line over N ¼ 2 from N 1-2 reset by Frazers 1/16 iron on line & true meridian could only set drag track solid rock bar. pinching Skeene Co line (N line Postures would fall 1.2 N of this comp corner

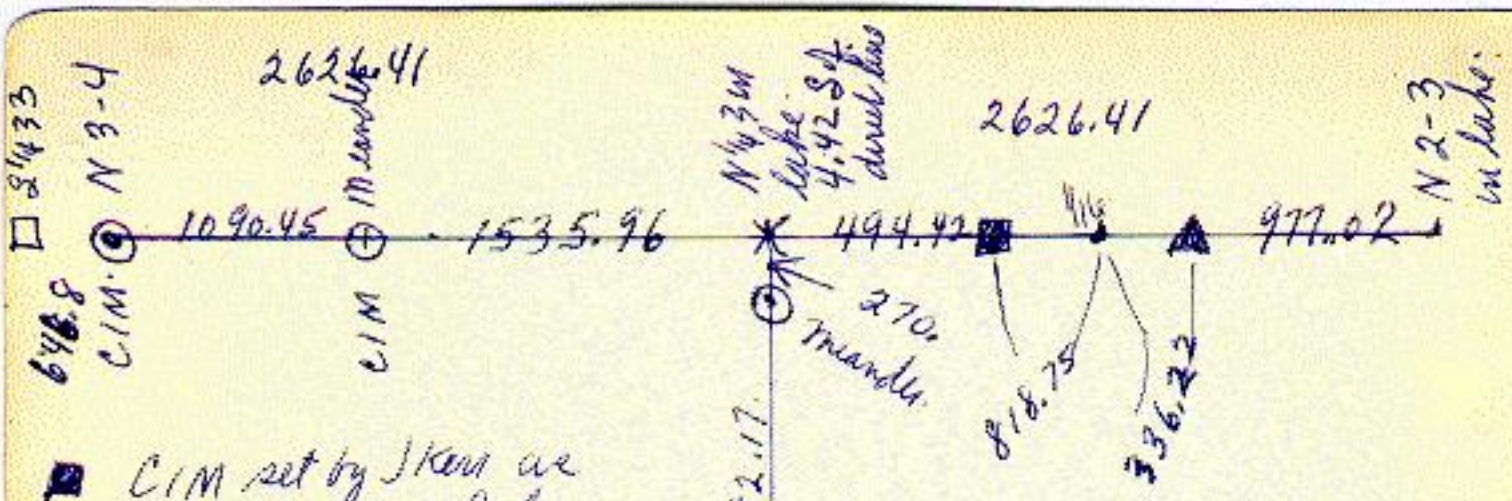

■ CIM set by J Kerr as SW cor Pochea Sub.

▲ CIM set by J Kerr as S E cor Pochea Point Sub

Grave not

line between these used as N line E½ Sec 3. to avoid changing entire line creating 4.42 kink at N¼ 3 and this line pushed east to E bay N 2-3 left 1.2 N & camp on lake.

CIM at ¼ set by J Kerr will be moved to above mean or 13.42 east (will not be CIM. unless as block corner ?