
11-18-81 Set C.I.C. 1p²

953305

South Section Corner 32-33 Goodhue Co. 109-15

11-6-81 Dug from a point under the E-W fence and 2631' from So. 1/4 Cor 32. East 7' West 5' South 3' and North 5' plus found absolutely nothing Had previously dug from East Edge of this hole east for 12'.

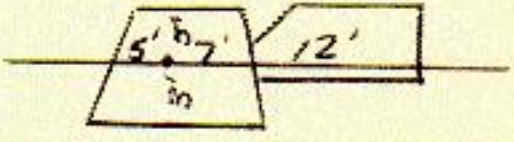

11-17-81 Set C.I.C. 1p² as the Corner midway between the So 1/4 Cor 32 and the So. 1/4 Cor. 33 and in line the average of of fence lines East and West. The Corner is 1' South of the E-W fence and 176 1/2' East of the C.P. of the old R/W fence running S.E. ly

Govt Notes: Surveyor Elisha S. Norris (Sept. 1853)
80:00 Set post in Mound with Charred stake
Trench and Pitts and Cherry stones planted
at each angle. for Corner to Sections 32 & 33