11-17-81 Set C.I.C. / D^2 over 1" Sq. Pipe set 11-3-81


953405

South Section Cor. 33-34 Goodhue Co. 109-15

11-2-81 Dug from Highum Iron ___ West and ___ North by 3½' Deep found nothing. Difficult to Tell depth to dig, Much Sediment

---

11-3-81 Continued digging here. Digging now as follows Found 2" diameter stake 18" long down 16" standing 13.06' West & .19' South of Highum's Iron (replaced). Removed stake to office & drove a 3/4" square pipe at its location Found nothing further. Chained 158' West to upper most river bank.

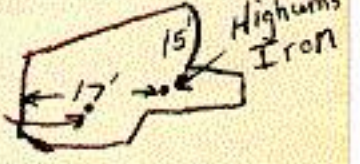

over

11-17-81 Set C.I.C./p^2 over 1" sq. Pipe set at the location of the stake found 11-3-81. Left Highum's Iron in place but drove it down. This Corner 56' north of the north edge of River and in old E-W fence line.

R.P.'s

Spike & C.S.D. in 16" Basswood	N.N.W.	28.7'
spike & C.S.D. in 16" Basswood	N.E.	54.24'
spike & C.S.D. in 9" some kind of Elm	S.W.	36.92

Gov't Notes: Surveyor Elisha S. Norris Sept. 1853 Set Post for Corners to sections 33 & 34

{Elm 12" N 57° W 38 Lks.
{Linden 12" N 65° E 12 Lks.