


BRIDGE NO. L-6173 C.R. 110
OVER LYNCH CREEK
OLMSTED COUNTY

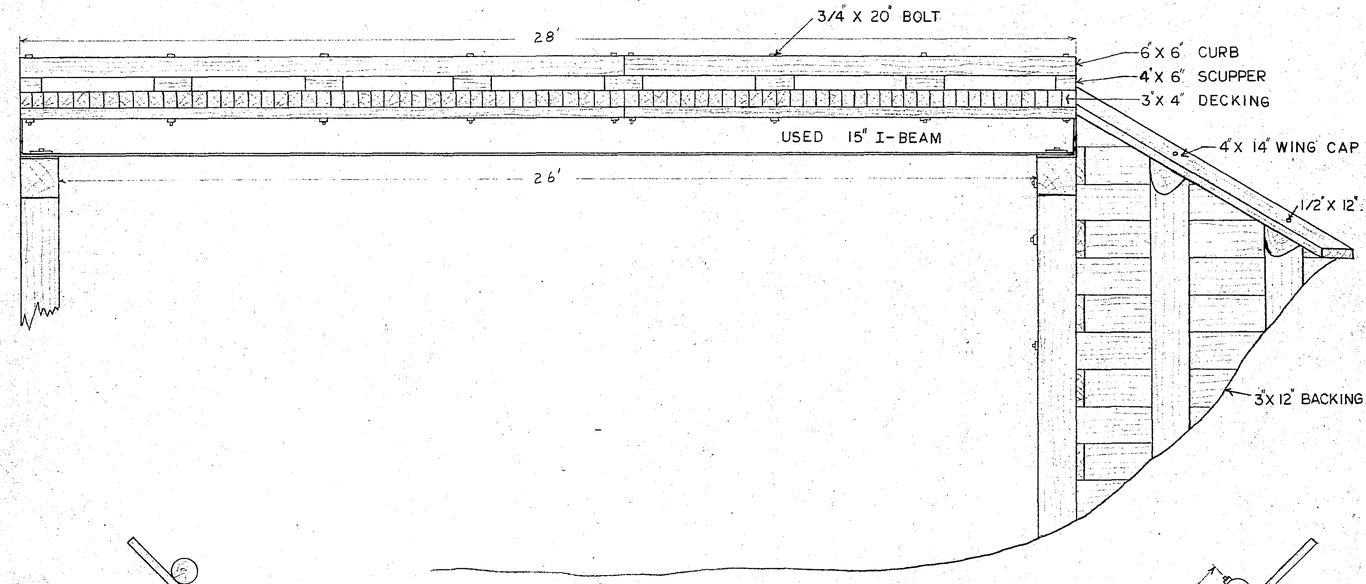


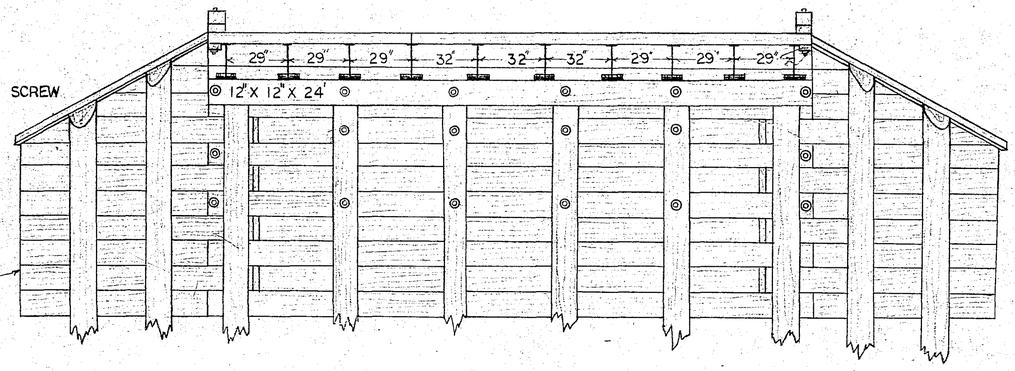



BILL OF MATERIALS


190 - 3" X 4" X 16' DECKING
12 - 12" X 30' PILING
8 - 12" X 25' PILING
2 - 12" X 12" X 28' PILE CAPS
30 - 3" X 12" X 24' BACKING
28 - 3" X 12" X 14' BACKING
12 - 6" X 6" X 7' STIFFENERS
2 - 6" X 6" X 12' WHEEL GUARD
2 - 6" X 6" X 16' WHEEL GUARD
1 - 4" X 6" X 14'
18 - 3/4" X 20" BOLTS NUTS & WASHERS
48 - 3/4" X 12" " " "
72 - 3/4" X 26" " " "
40 - 8" LAG SCREWS
20 - BEARING PLATE & KICKER ASS.
320 - DECKING CLIPS
NAILS
2 - 4" X 14" X 14' WING CAPS
8 - 1/2" X 12" LAG SCREWS

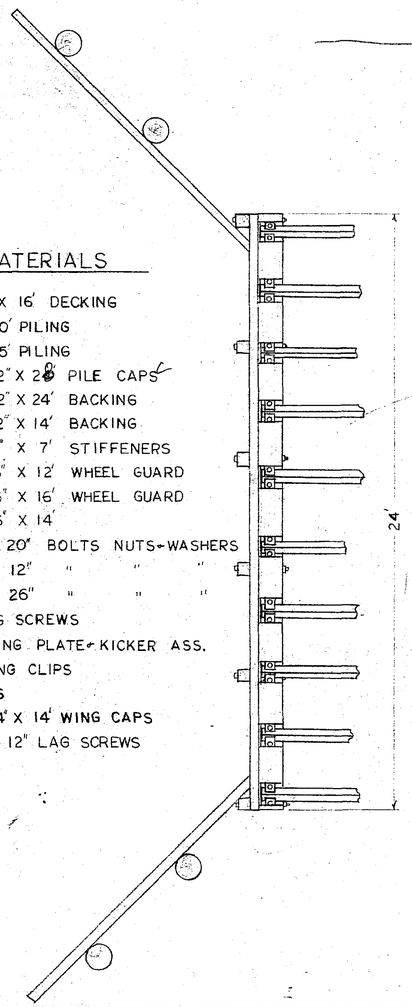

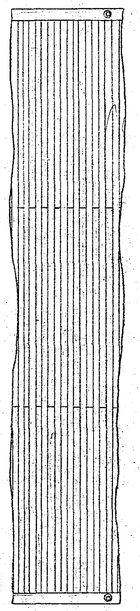


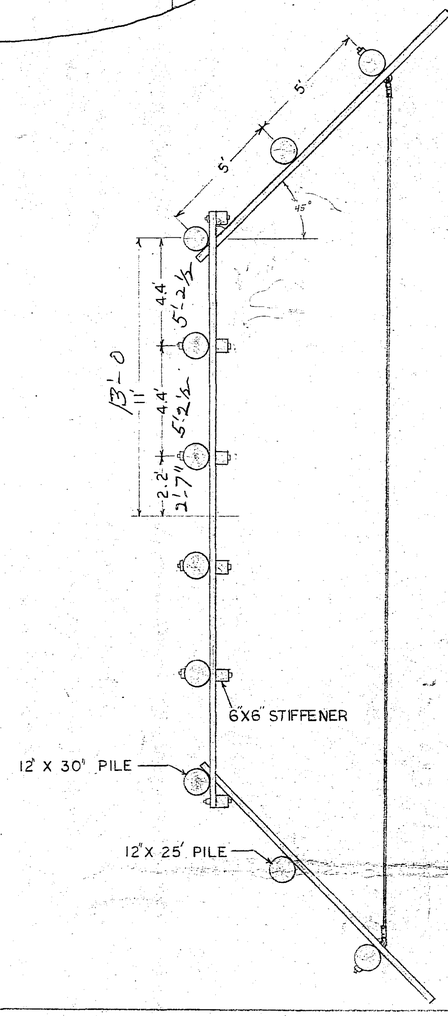

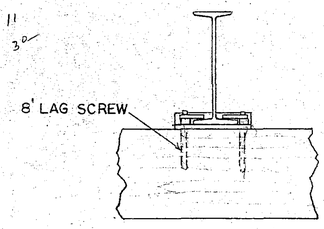

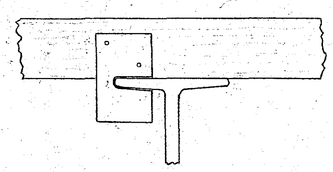

TOP OF DECK ELEV. 985.3'
PILE CUT-OFF ELEV. 982.66'
BOTTOM OF PILE BACKING 970.3'

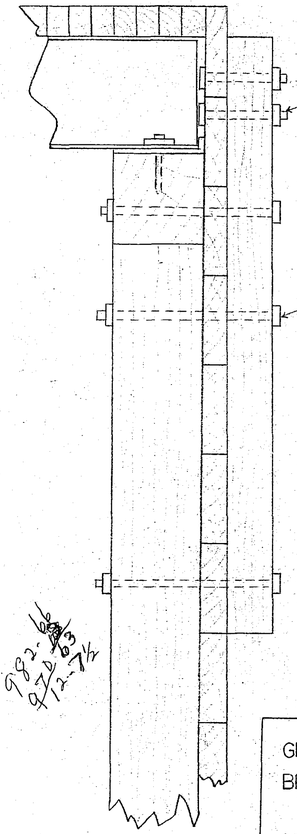

12'-4½ below cap

I hereby certify that this plan, specification or report was prepared by me or under my direct supervision and that I am a duly Registered Professional Engineer under the laws of the State of Minnesota.

Date 8-1-74 Reg. No. 8234

ARTHUR C. SCHELLHAMMER
REGISTERED PROFESSIONAL ENGINEER
8234
STATE OF MINNESOTA

GENERAL PLAN & ELEVATION
BRIDGE NO. L6173 CO. RD. NO. 110
OVER LYNCH CREEK
NE1/4 SEC. 22 ELMIRA TOWNSHIP
26 FT. BEAM SPAN - 24 FT. RD. WAY
OLMSTED COUNTY - DEPARTMENT OF HIGHWAYS
DRAWN BY DAVID SCHELLHAMMER 7/31/74