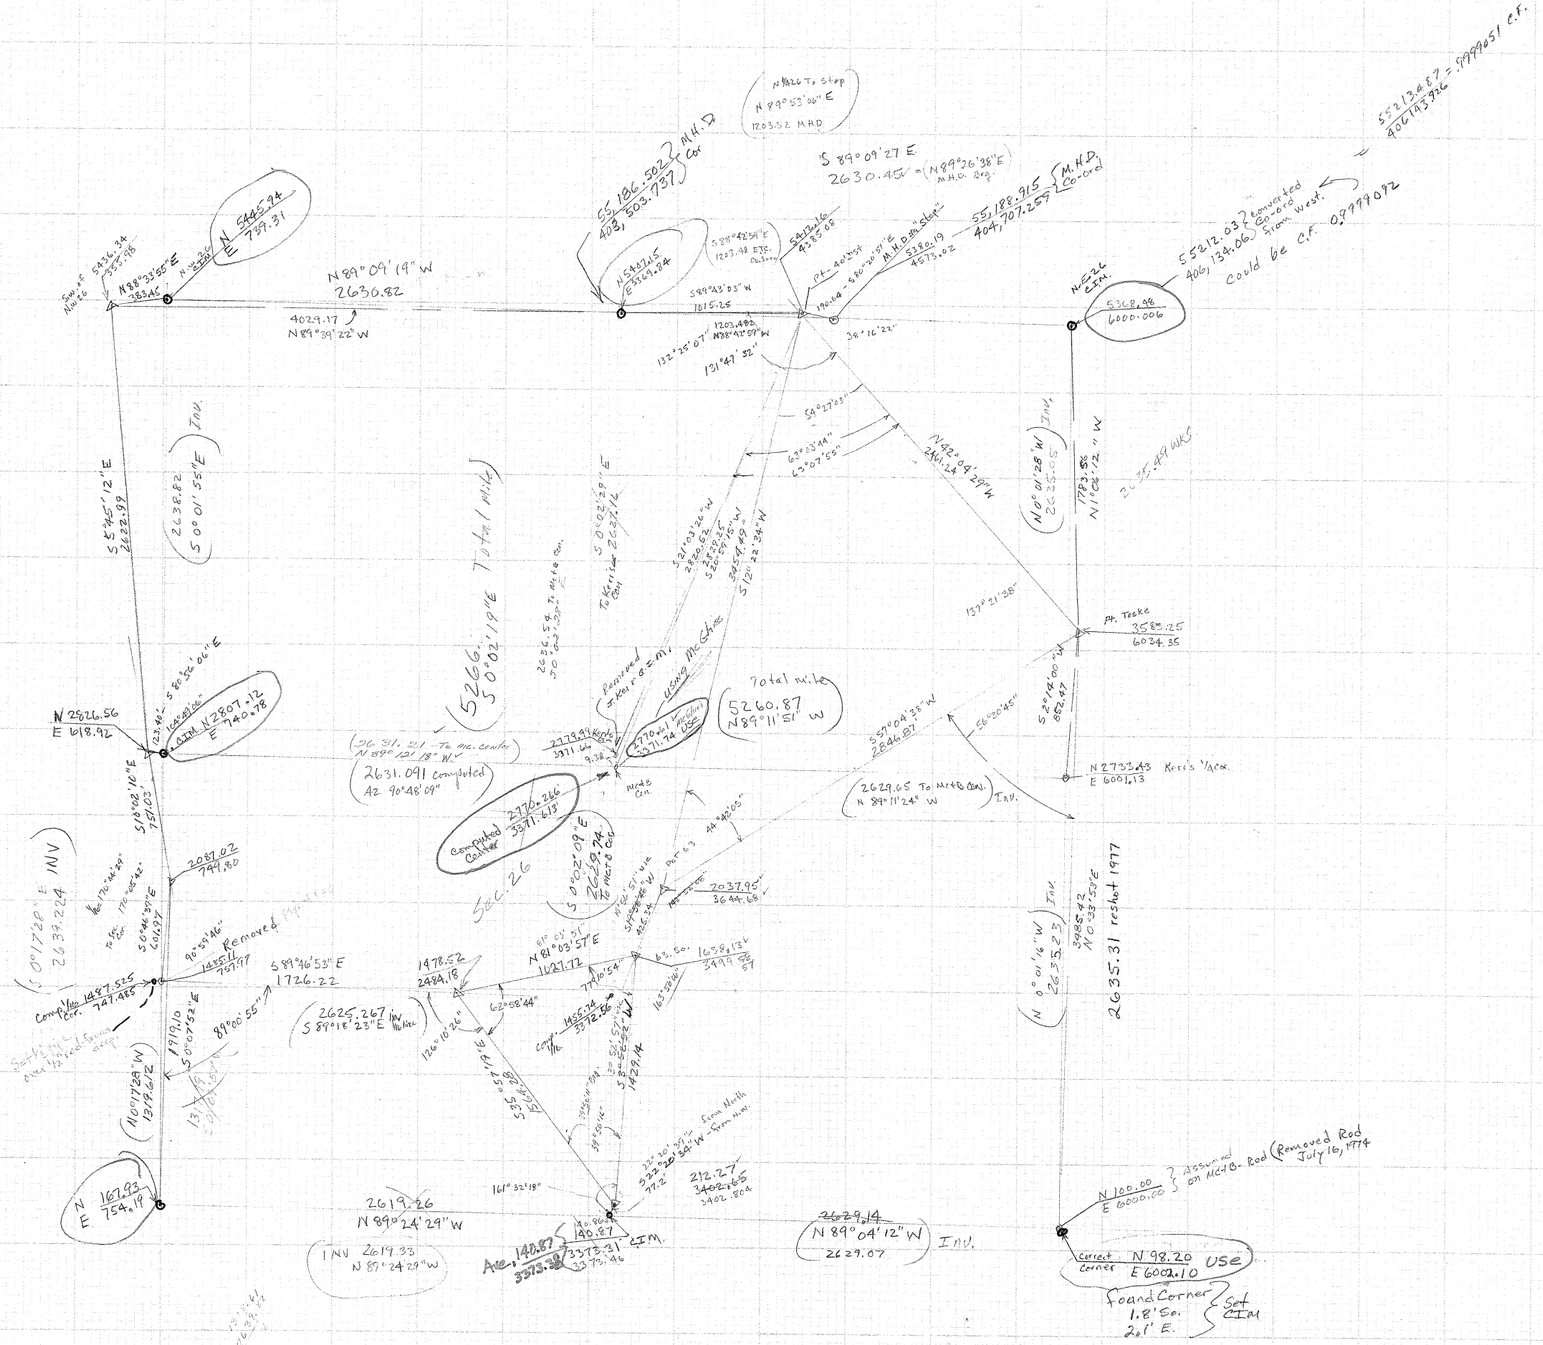


Sec 26 - 106 - 14
Rochester Twp.

July 1974

Sec. 26-106-14 3-11

Drwg No. 3-11