Survey Number _____

Date May 17 1973 ~~194~~

Made at the request of _____


owners of the following described land _____

Sec. 16 – 105 – 13

who were notified and present _____

Chainman _____ Fees _____ Chainman _____ Fees _____

Chainman _____ Fees _____ Chainman _____ Fees _____

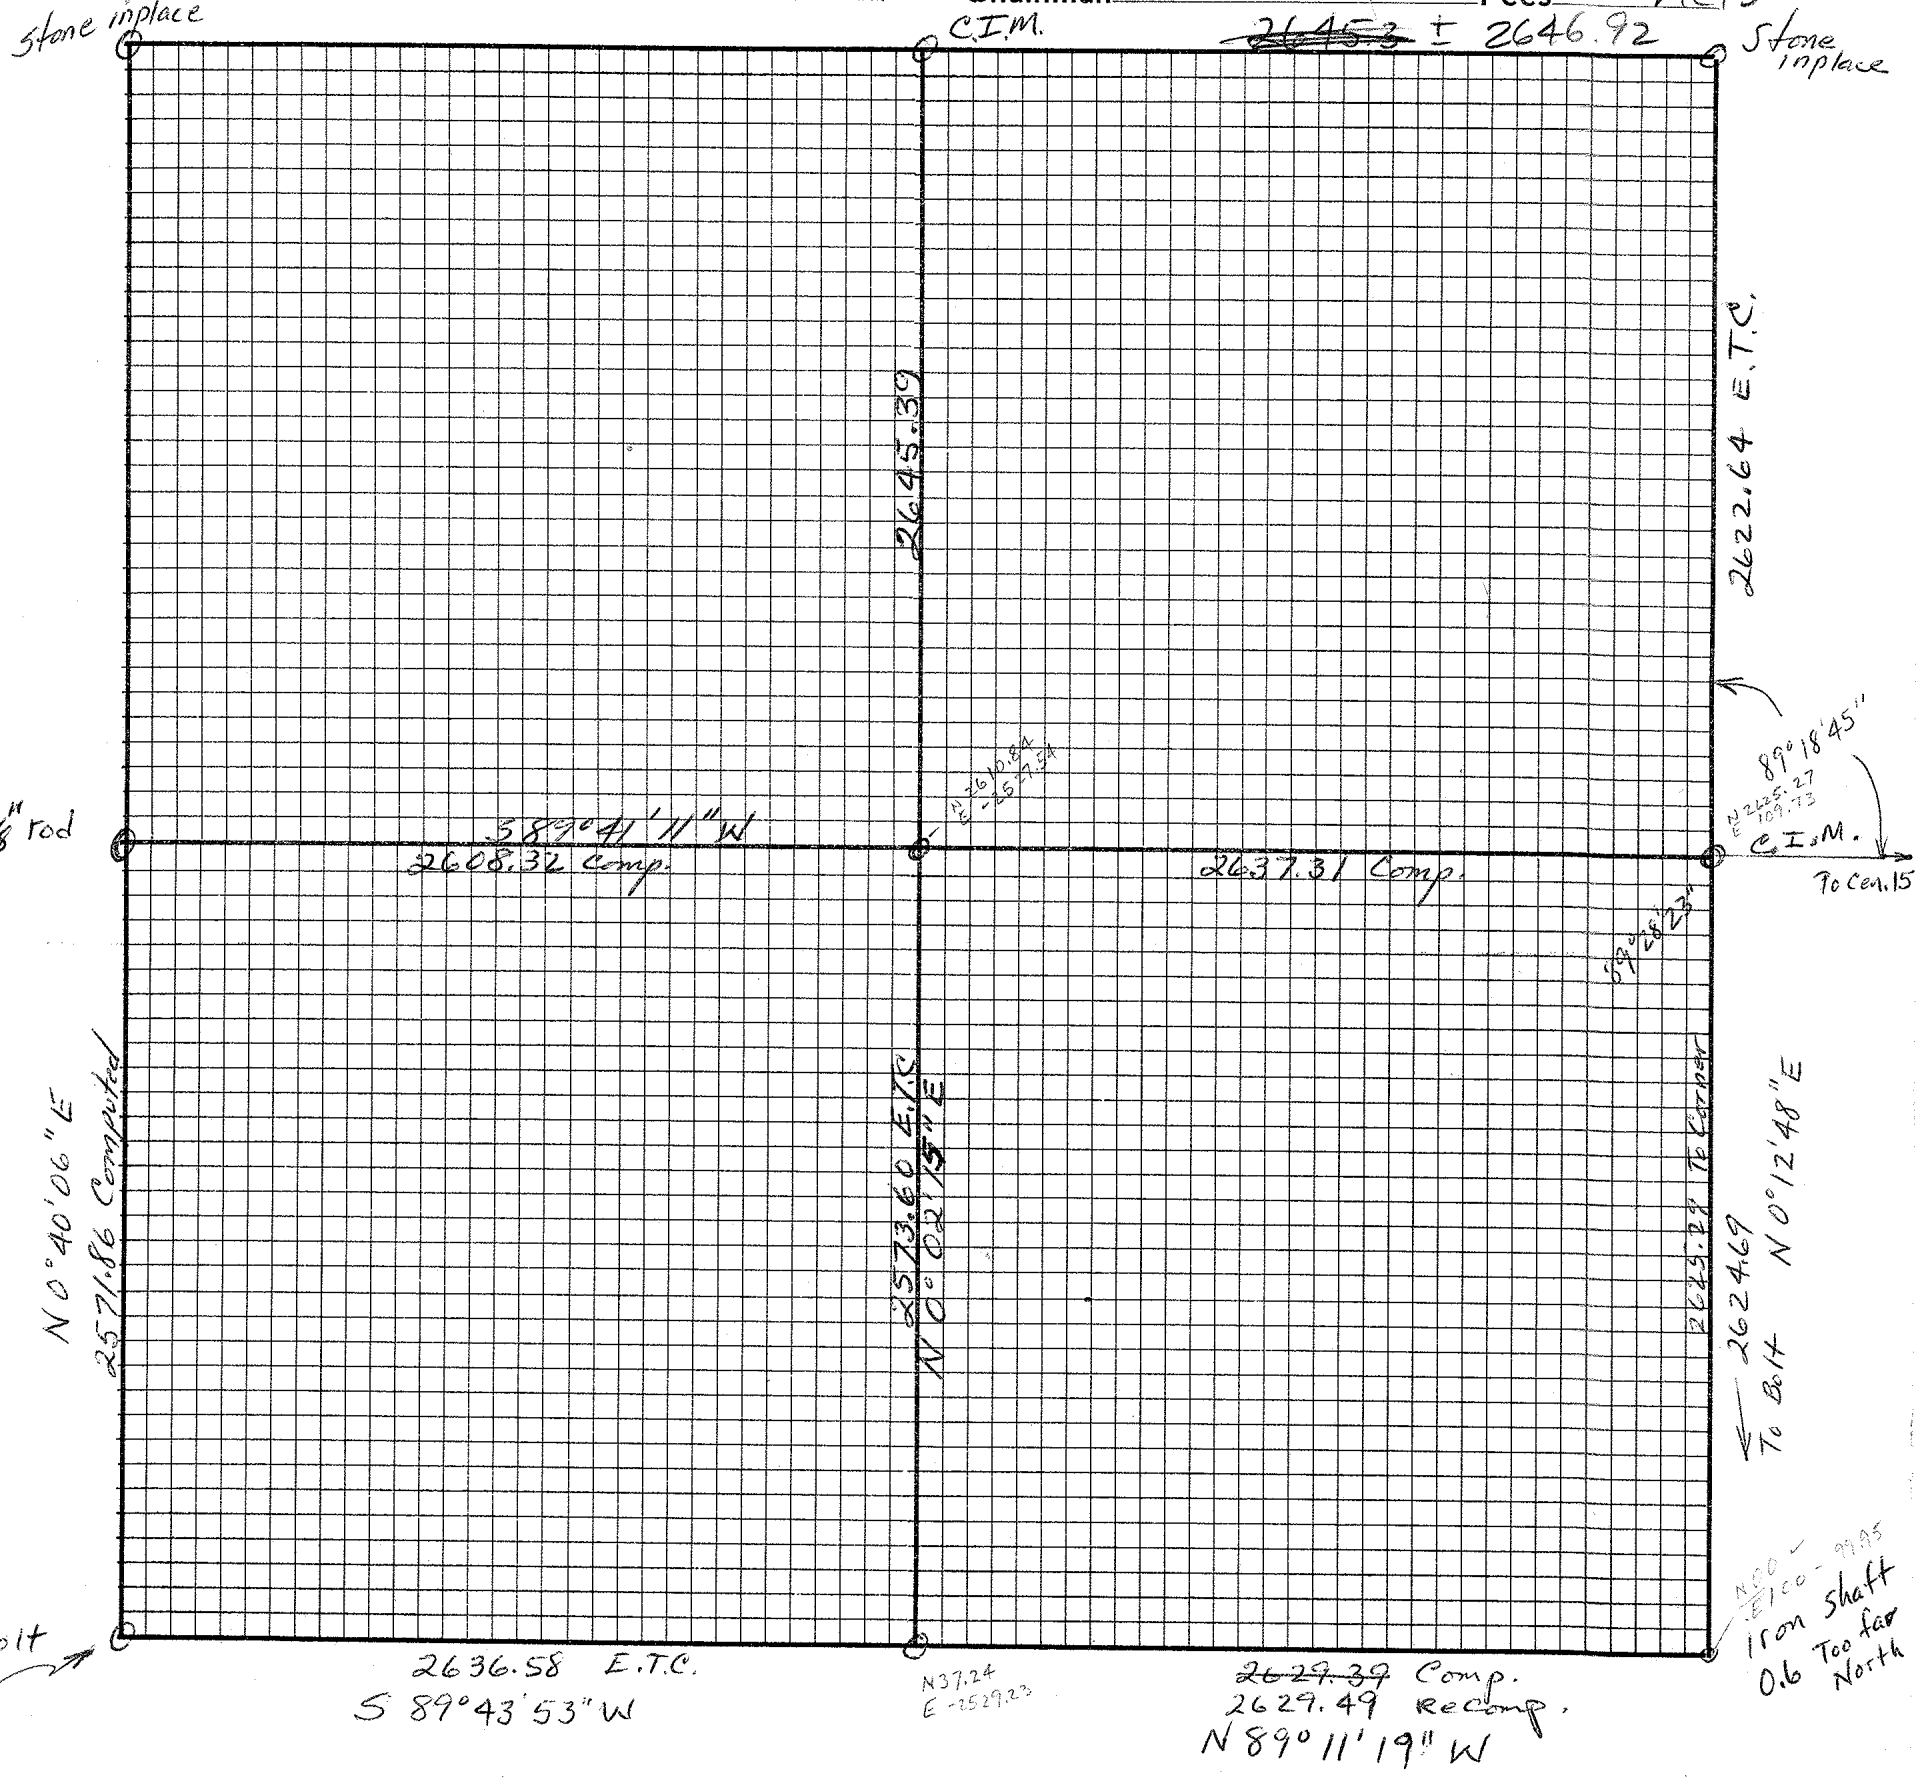

Note: Bearings Assumed

Sec. 16 - 105 - 13

3-21