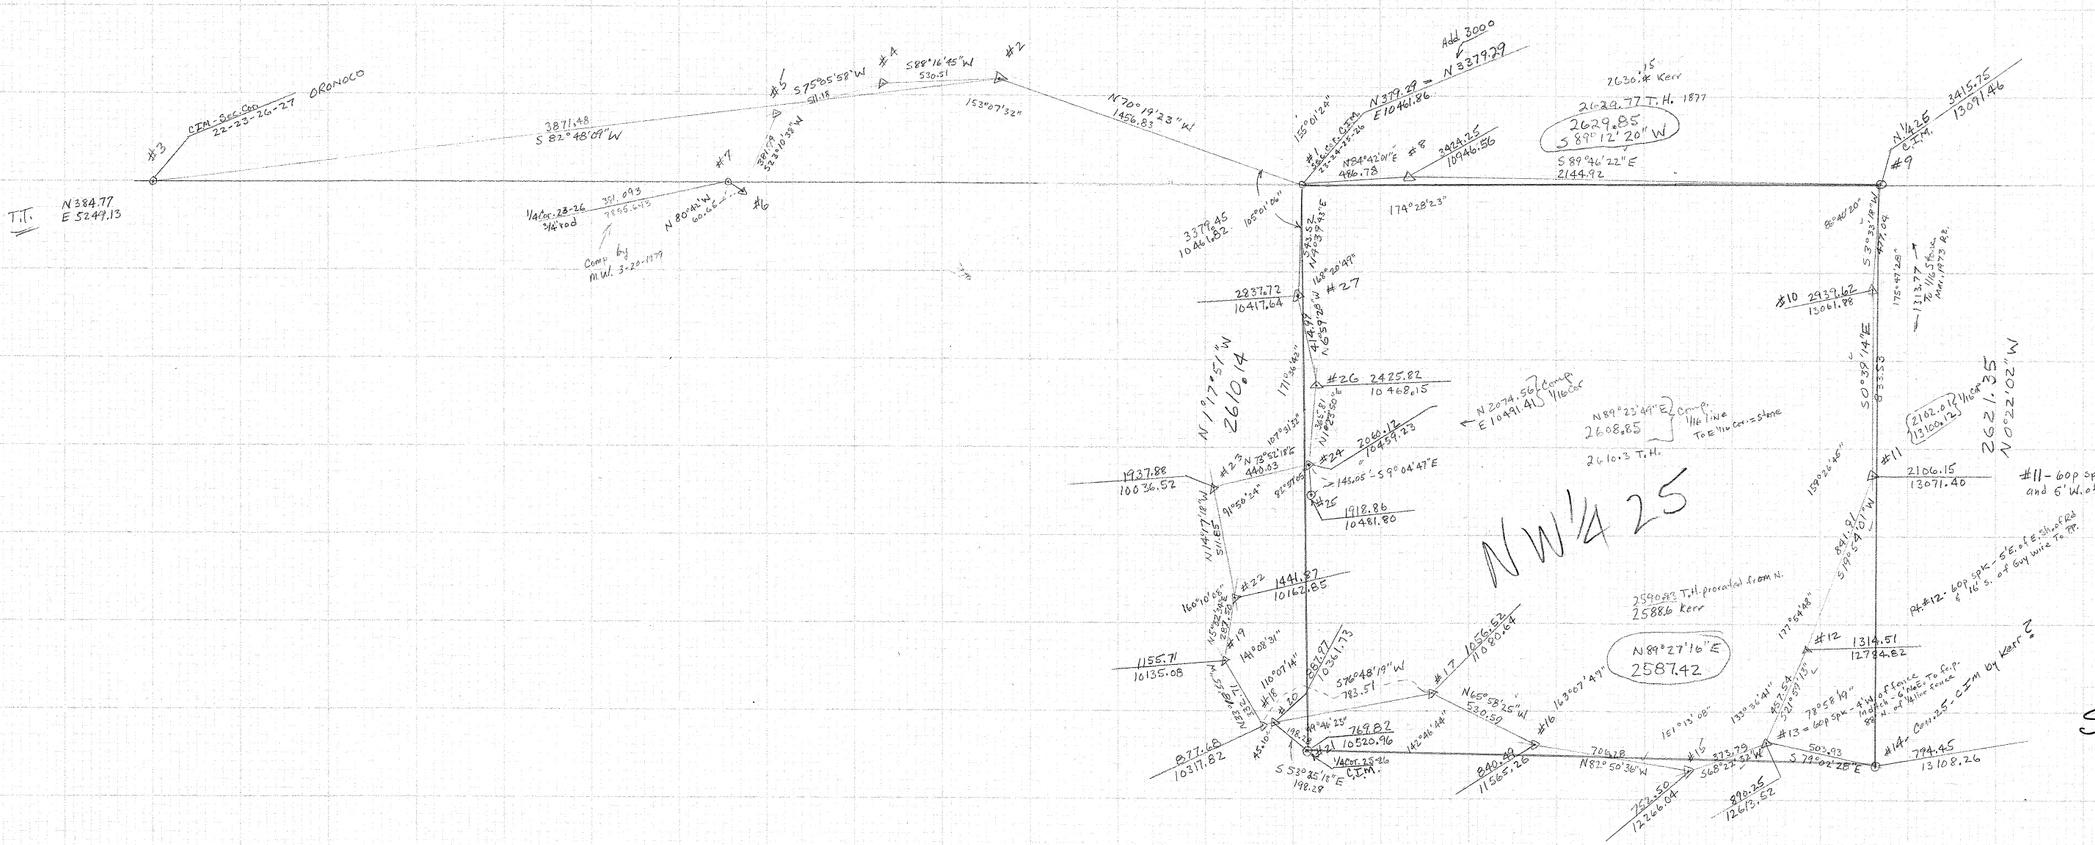


Note: This Work done by T. Taylor - Apr. & May 1974 Copied from Their field notes on Mar. 5, 1975 by R.B.

Note: CO-ord. are different from other work To west.

3-23

Sec. 25-26 - 108-14

Drwg No. 3-23