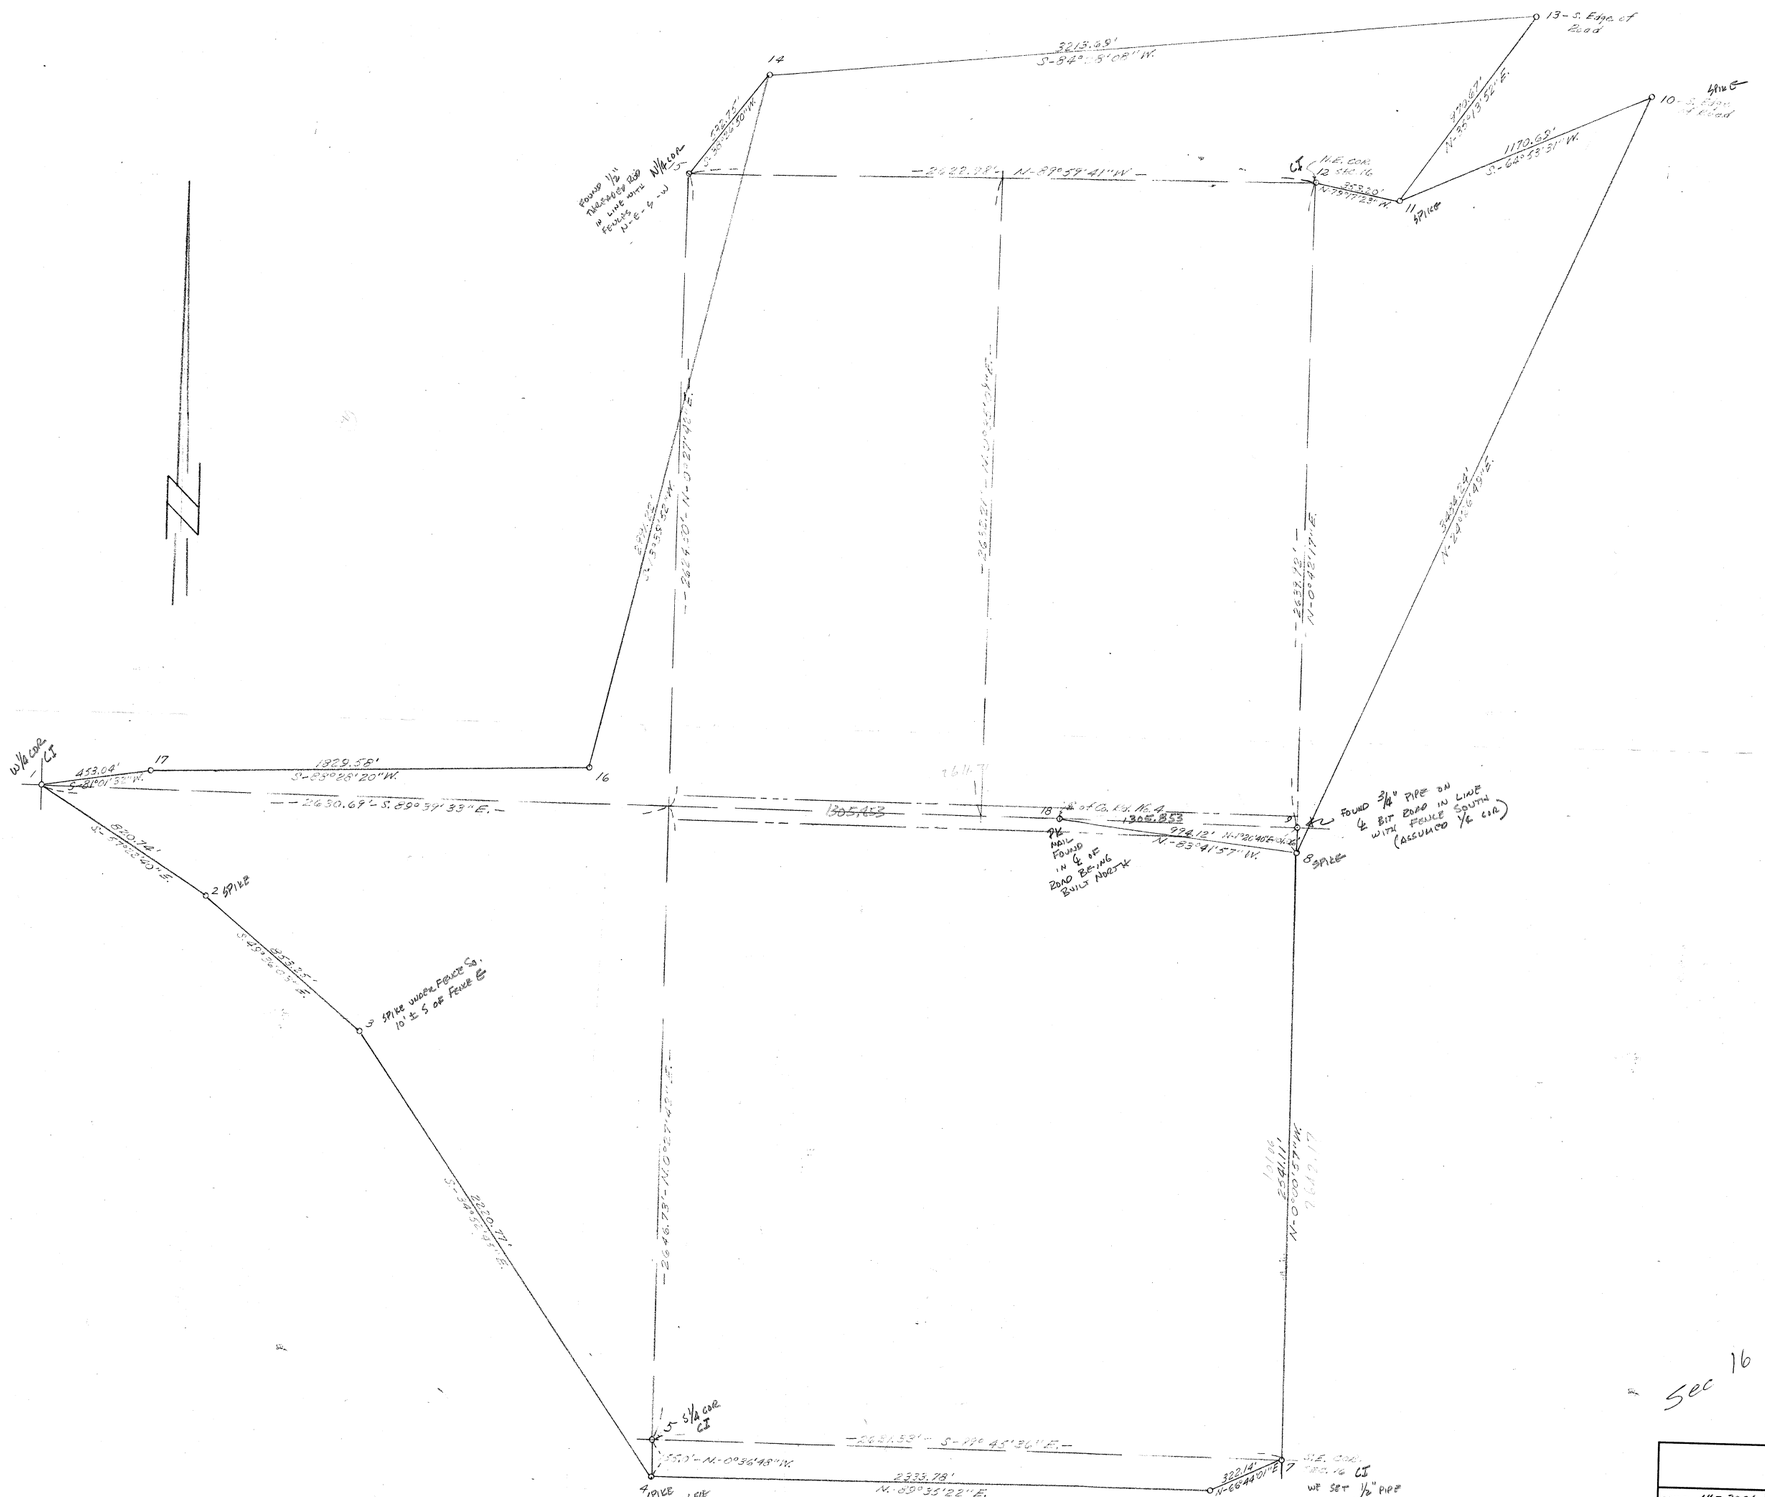


Sec 16 Kalmar Twp.

SCALE: 1" = 300'	APPROVED BY	DRAWN BY
DATE: 4-11-73	BOUNDARY SURVEY, DALY PROPERTY N.E. 1/4 SEC. 16, T 30 N., R. 15	
		DRAWING NUMBER 554-73

3-32

DIETZGEN MASTER FORM 120MF PRINTED ON DIETZGEN 120M AGEPROOF VELLUM