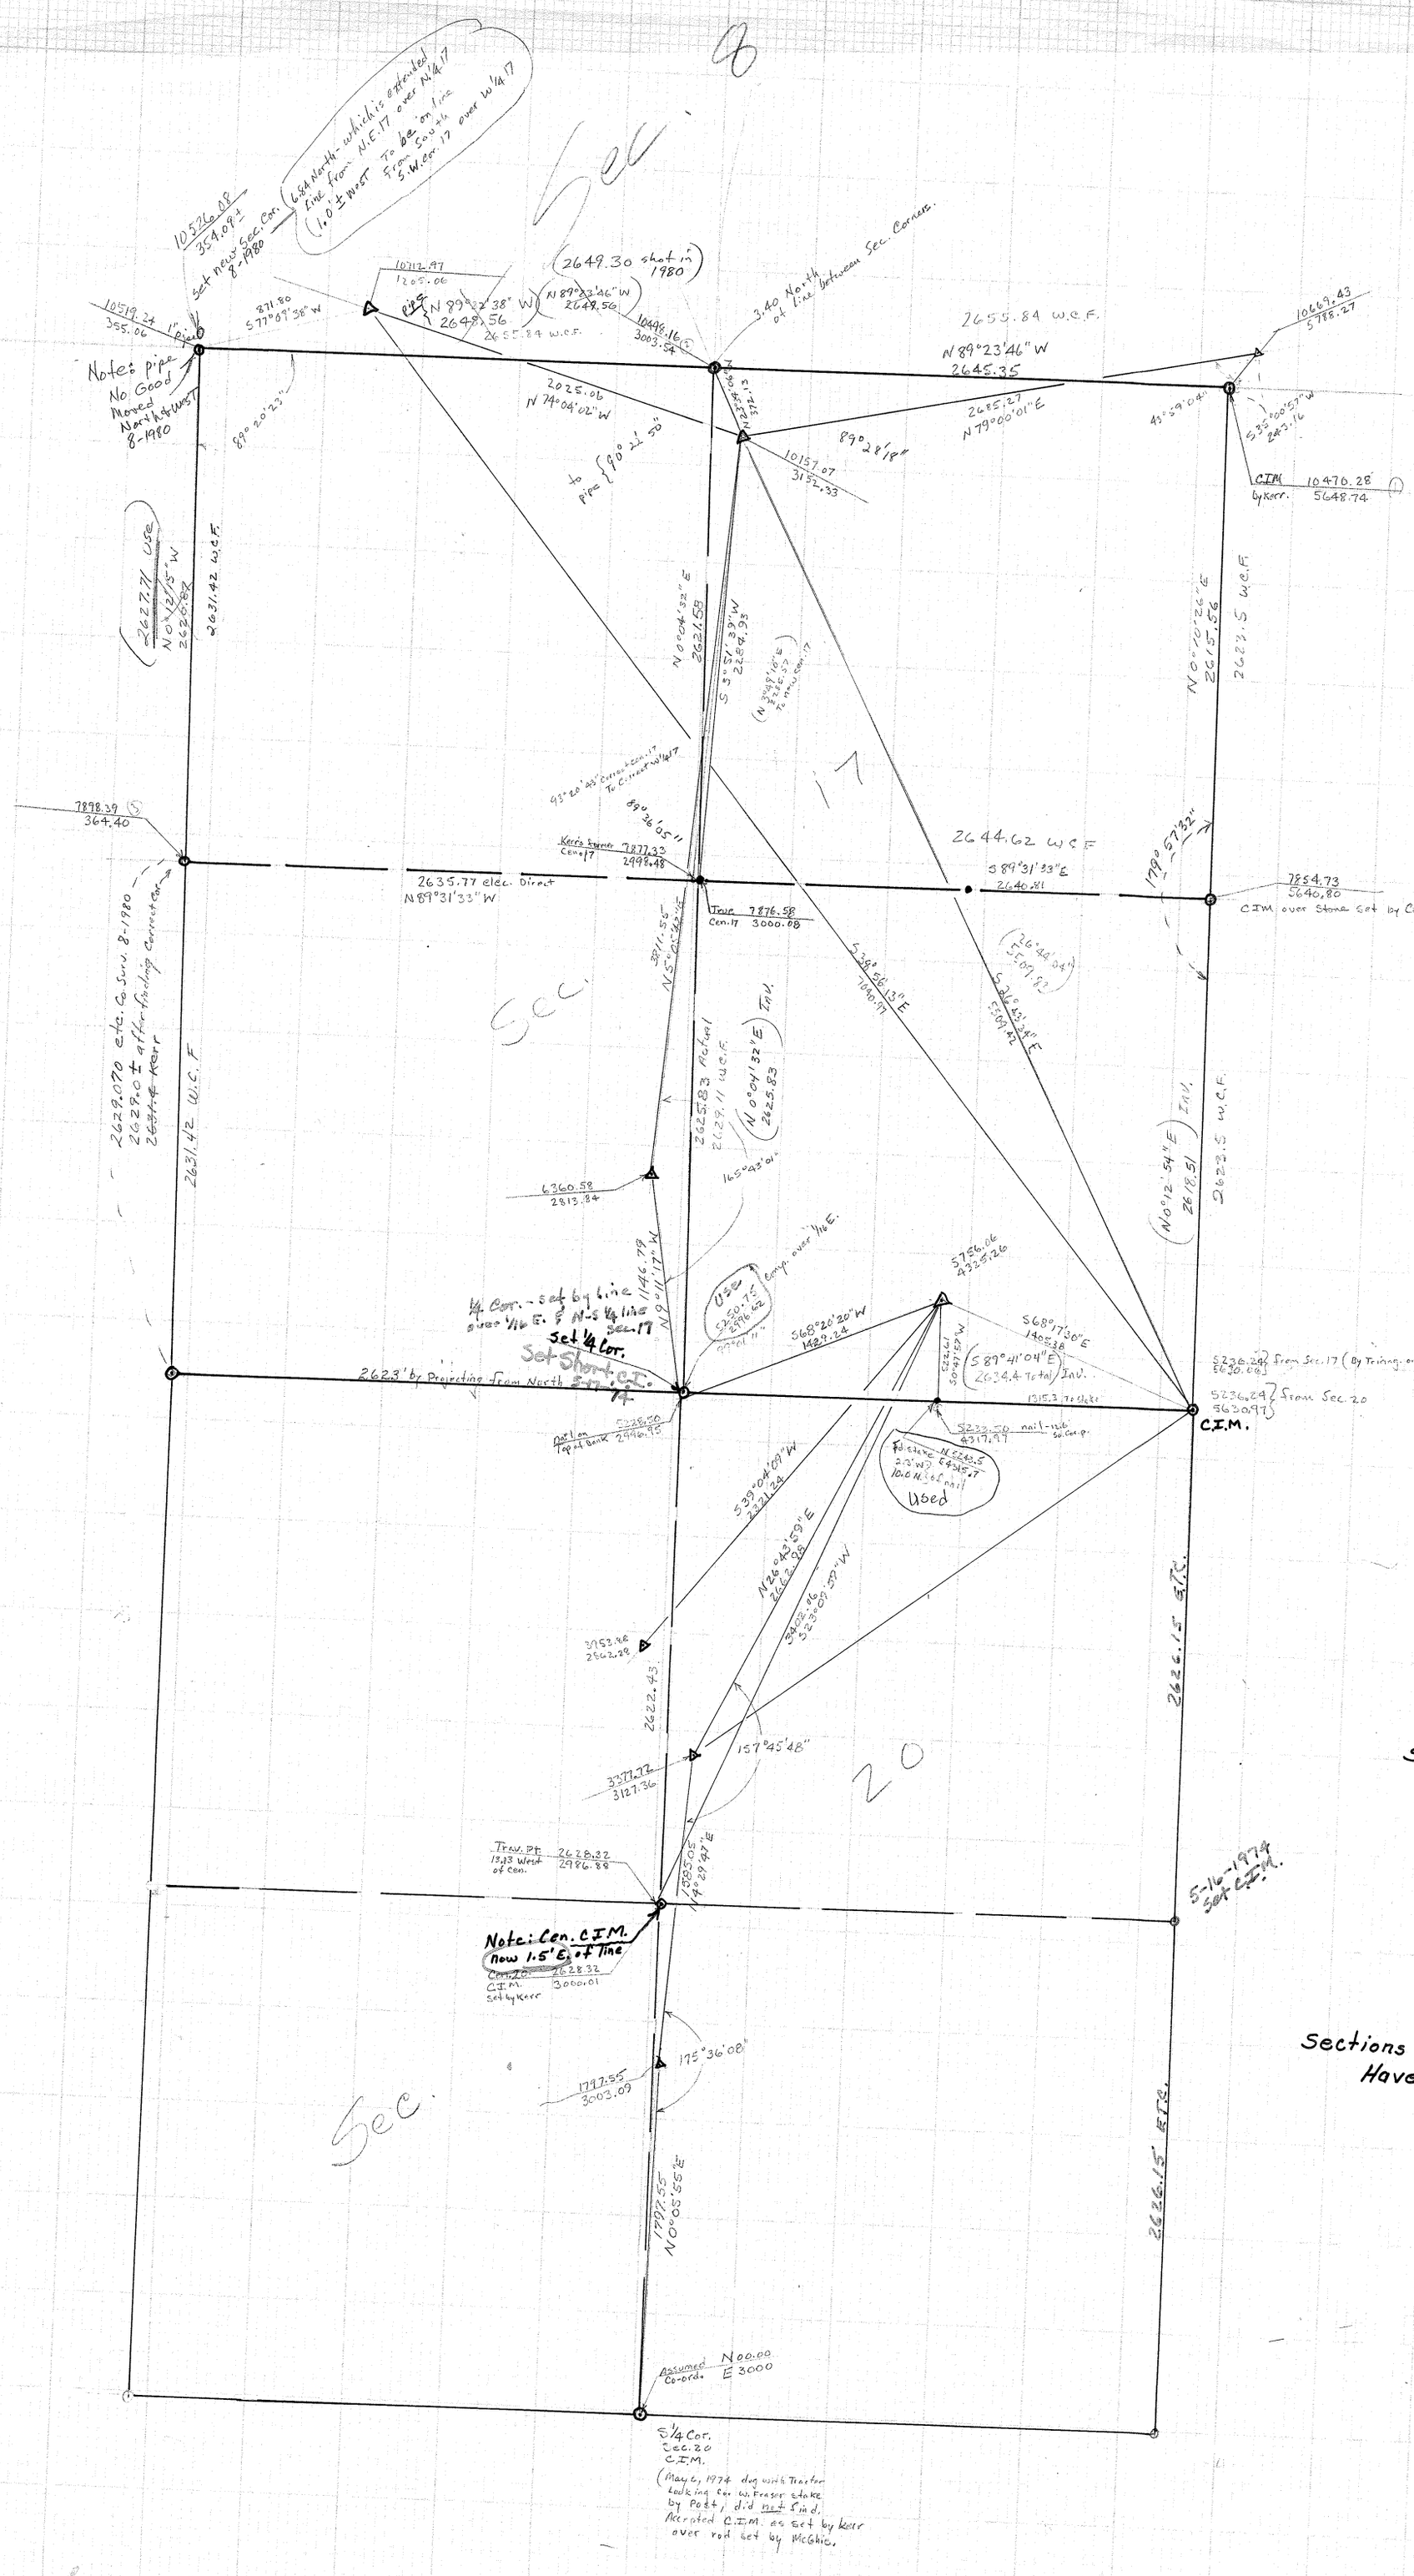


Sections 17 & 20 – 107-13
Haverhill Twp.

May 1974
County Surveyor

3-42