

EYOTA TOWNSHIP 106 - 12

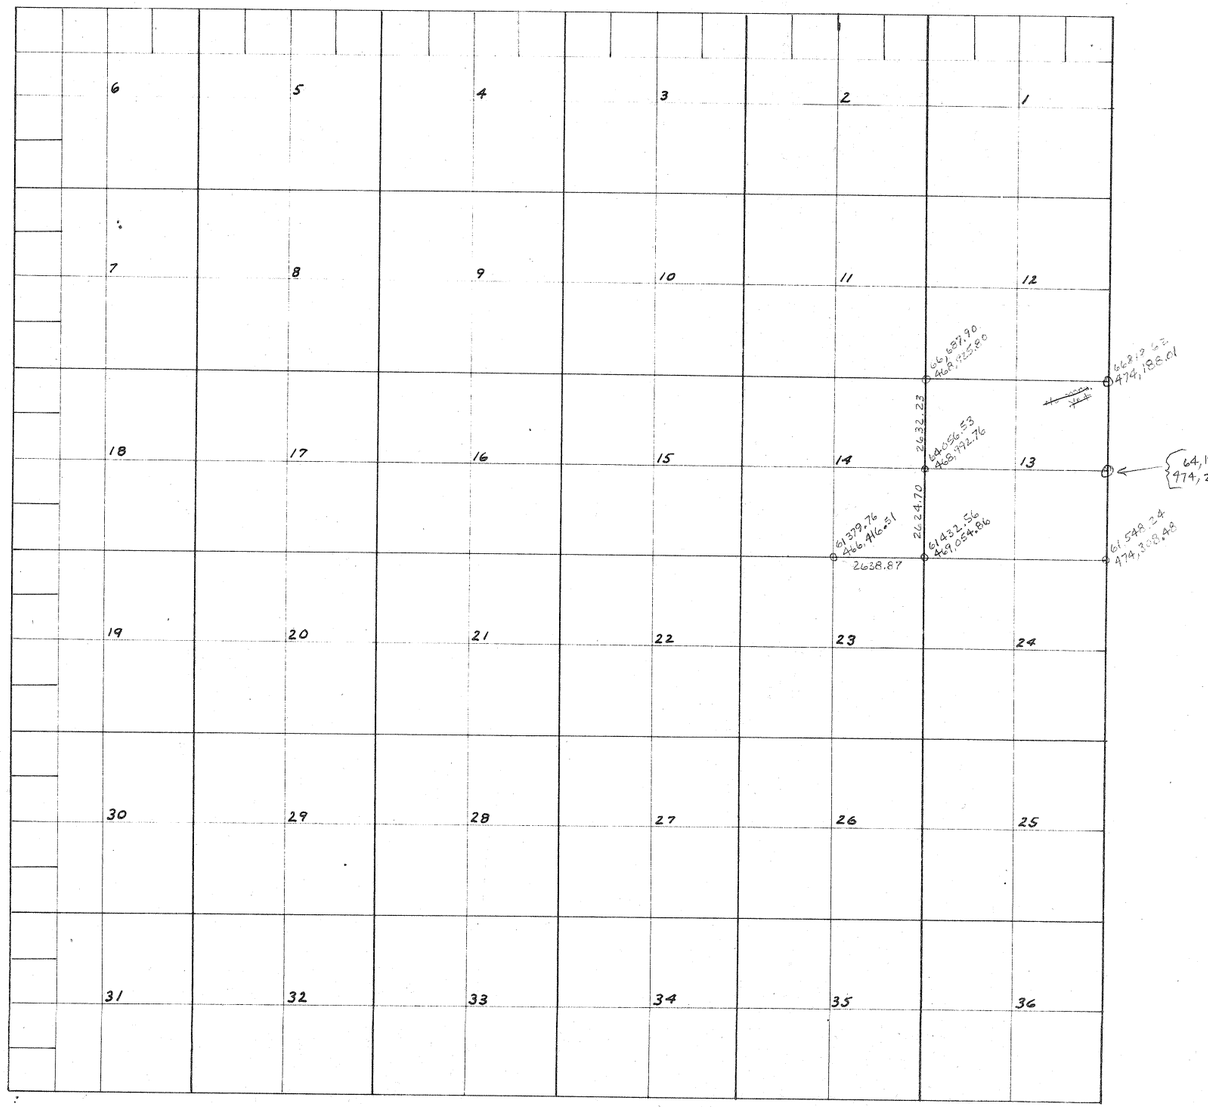

DOVER TOWNSHIP 106 - 11

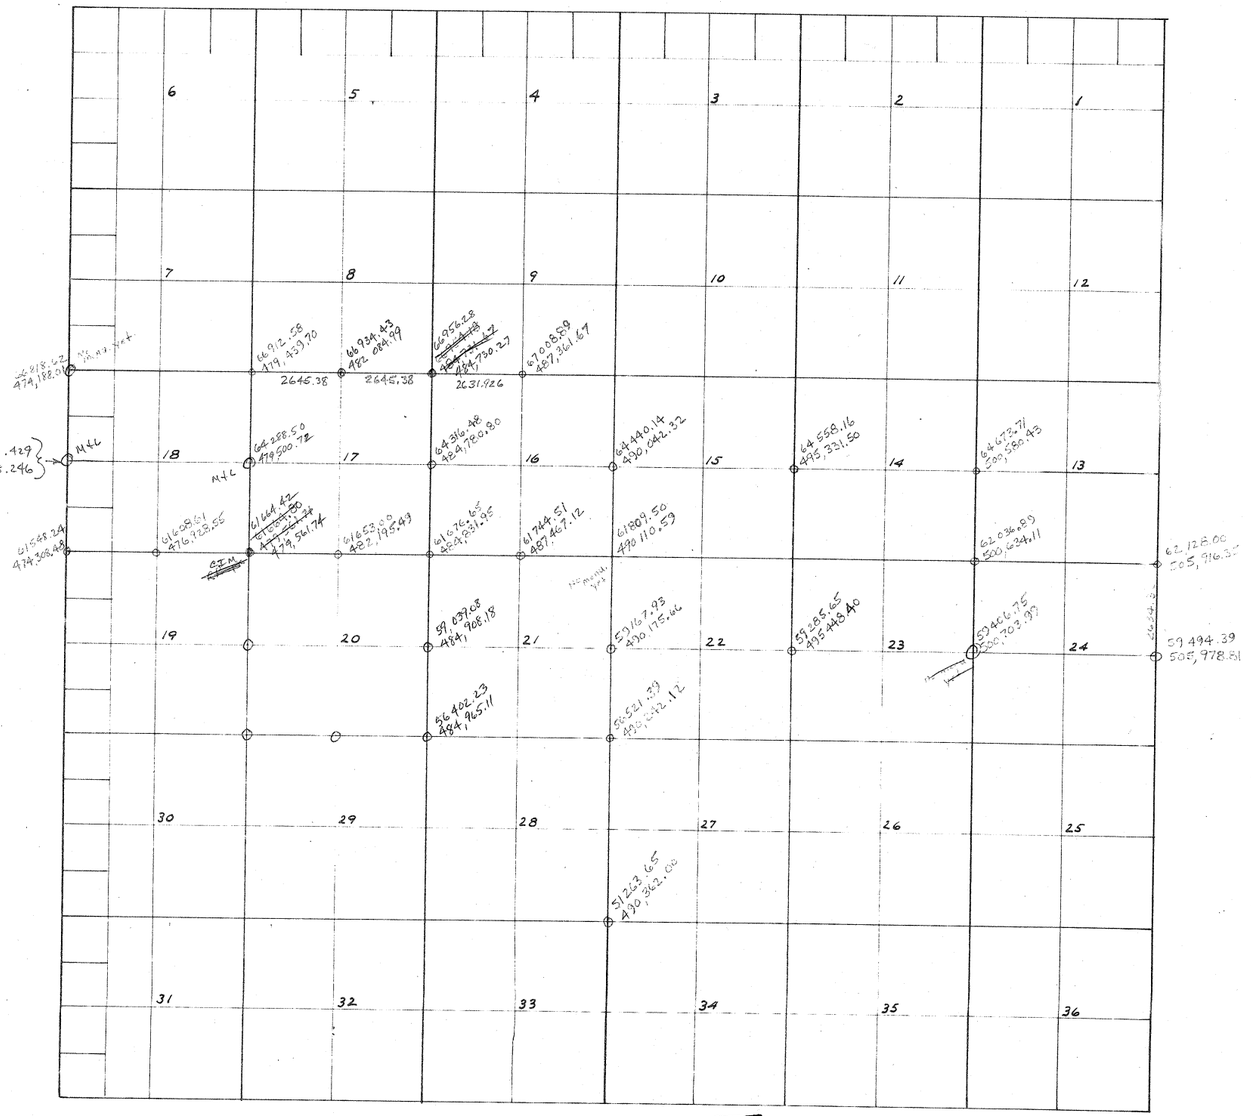

Olmsted County Project Co-ordinates:
State Plane Co-ord ÷ by .9999051 Combined Scale Factor
- 300,000 in Northing
- 2,000,000 in Easting

3-45B

Olmsted County Surveyor
Sept. 2, 1975

3-45b