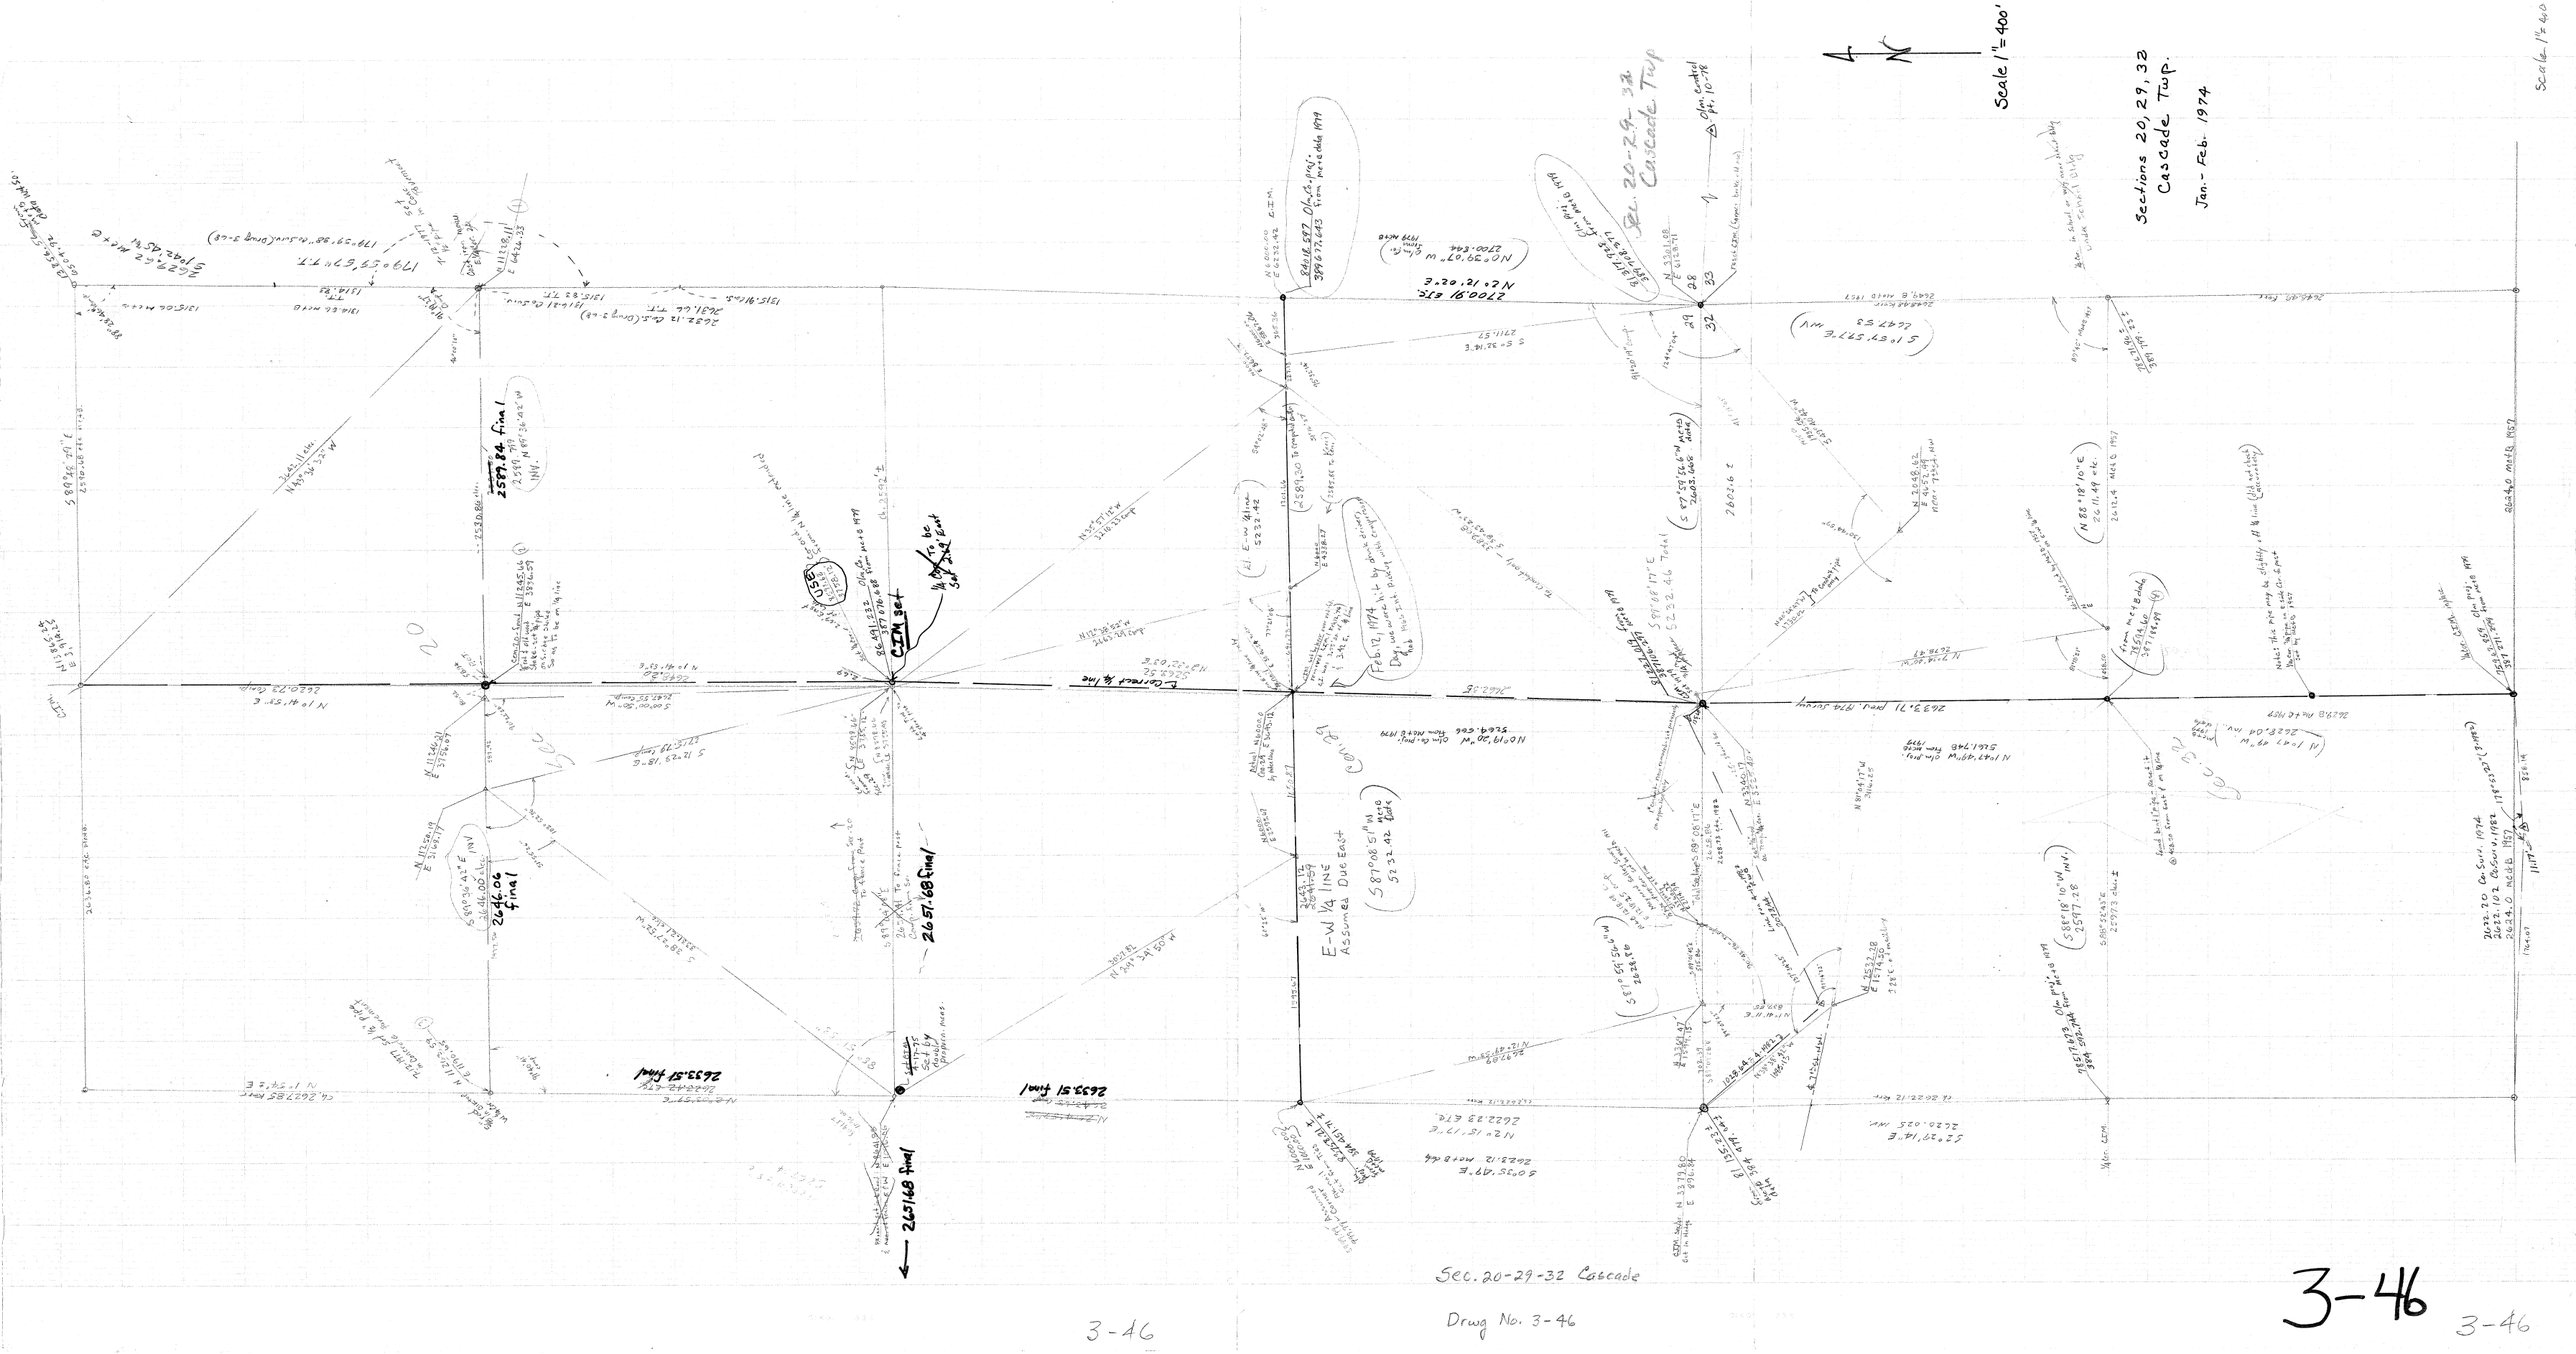

Sections 20, 29, 32
Cascade Twp.
Jan.- Feb. 1974
Scale 1" = 400'
Sec. 20-29-32 Cascade Twp
E-W 1/4 LINE
Assumed Due East
2597.84 final
2646.06 final
2657.68 final
2633.51 final
2651.48 final
Sec. 20-29-32 Cascade
Drwg No. 3-46
3-46