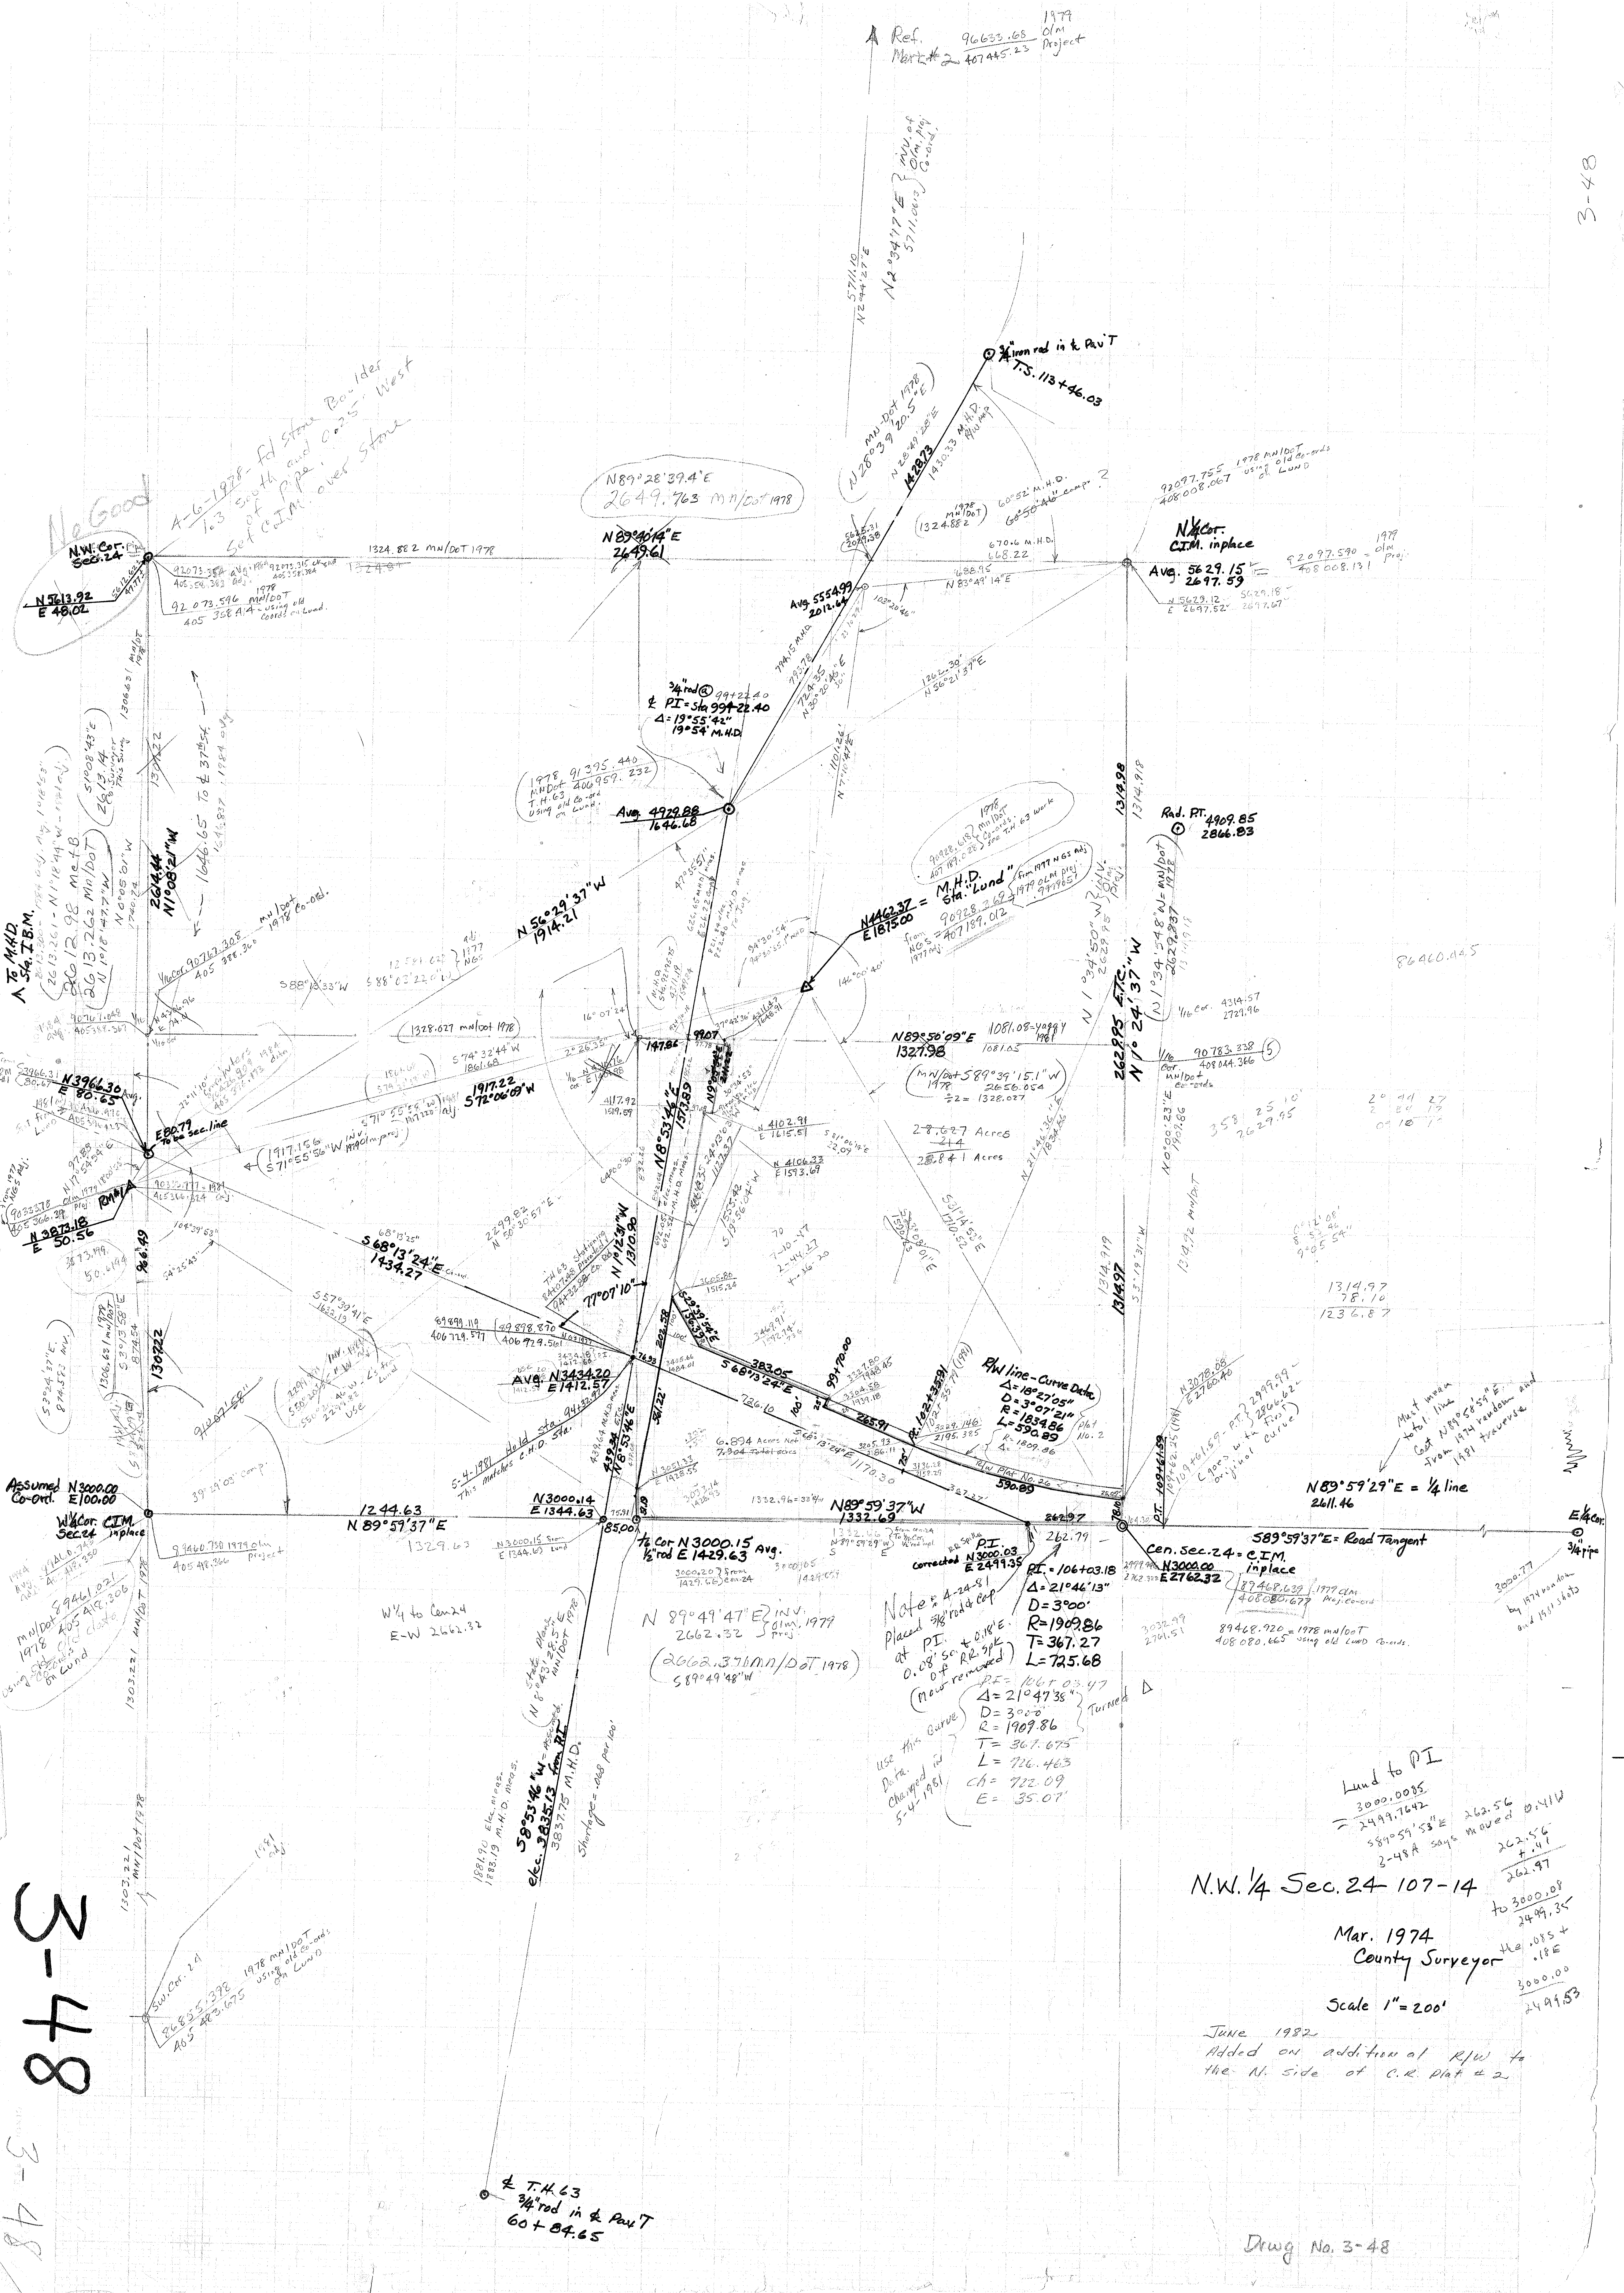

N.W. 1/4 Sec. 24-107-14
Mar. 1974
County Surveyor
Scale 1" = 200'
June 1982
Added on addition of R/W to the N. side of C.R. Plat # 2
Drwg No. 3-48
Lund to PI
N 1/4 Cor. C.I.M. inplace
Avg. 5629.15 2697.59
E 1/4 Cor. 3/4" pipe
N89°59'29"E = 1/4 line
2611.46
S89°59'37"E = Road Tangent
Cen. Sec. 24 = C.I.M. inplace
N3000.00
E2762.32
R/W line - Curve Data
Δ = 18°27'05"
D = 3°07'21"
R = 1834.86
L = 590.89
PI = 106+03.18
Δ = 21°46'13"
D = 3°00'
R = 1909.86
T = 367.27
L = 725.68
Rad. Pt. 4909.85 2866.83
M.H.D. Sta. "Lund"
N4462.37 E1875.00
3/4" iron rod in ℄ Pav't T.S. 113+46.03
Ref. Mark # 2
N89°59'37"W
1332.69
1/4 Cor N3000.15 Avg. 1/2" rod E1429.63
N3000.14 E1344.63
Avg. N3434.20 E1412.57
S68°13'24"E 1434.27
S68°13'24"E 383.05
1244.63
N89°59'37"E
W 1/4 Cor. C.I.M. Sec. 24 inplace
Assumed Co-Ord. N3000.00 E100.00
N.W. Cor. Sec. 24
N.5613.92
E 48.02
To M.H.D. Sta. T.B.M.
2614.44
N1°08'21"W
℄ T.H. 63
3/4" rod in ℄ Pav't
60+84.65
S8°53'46"W
3-48