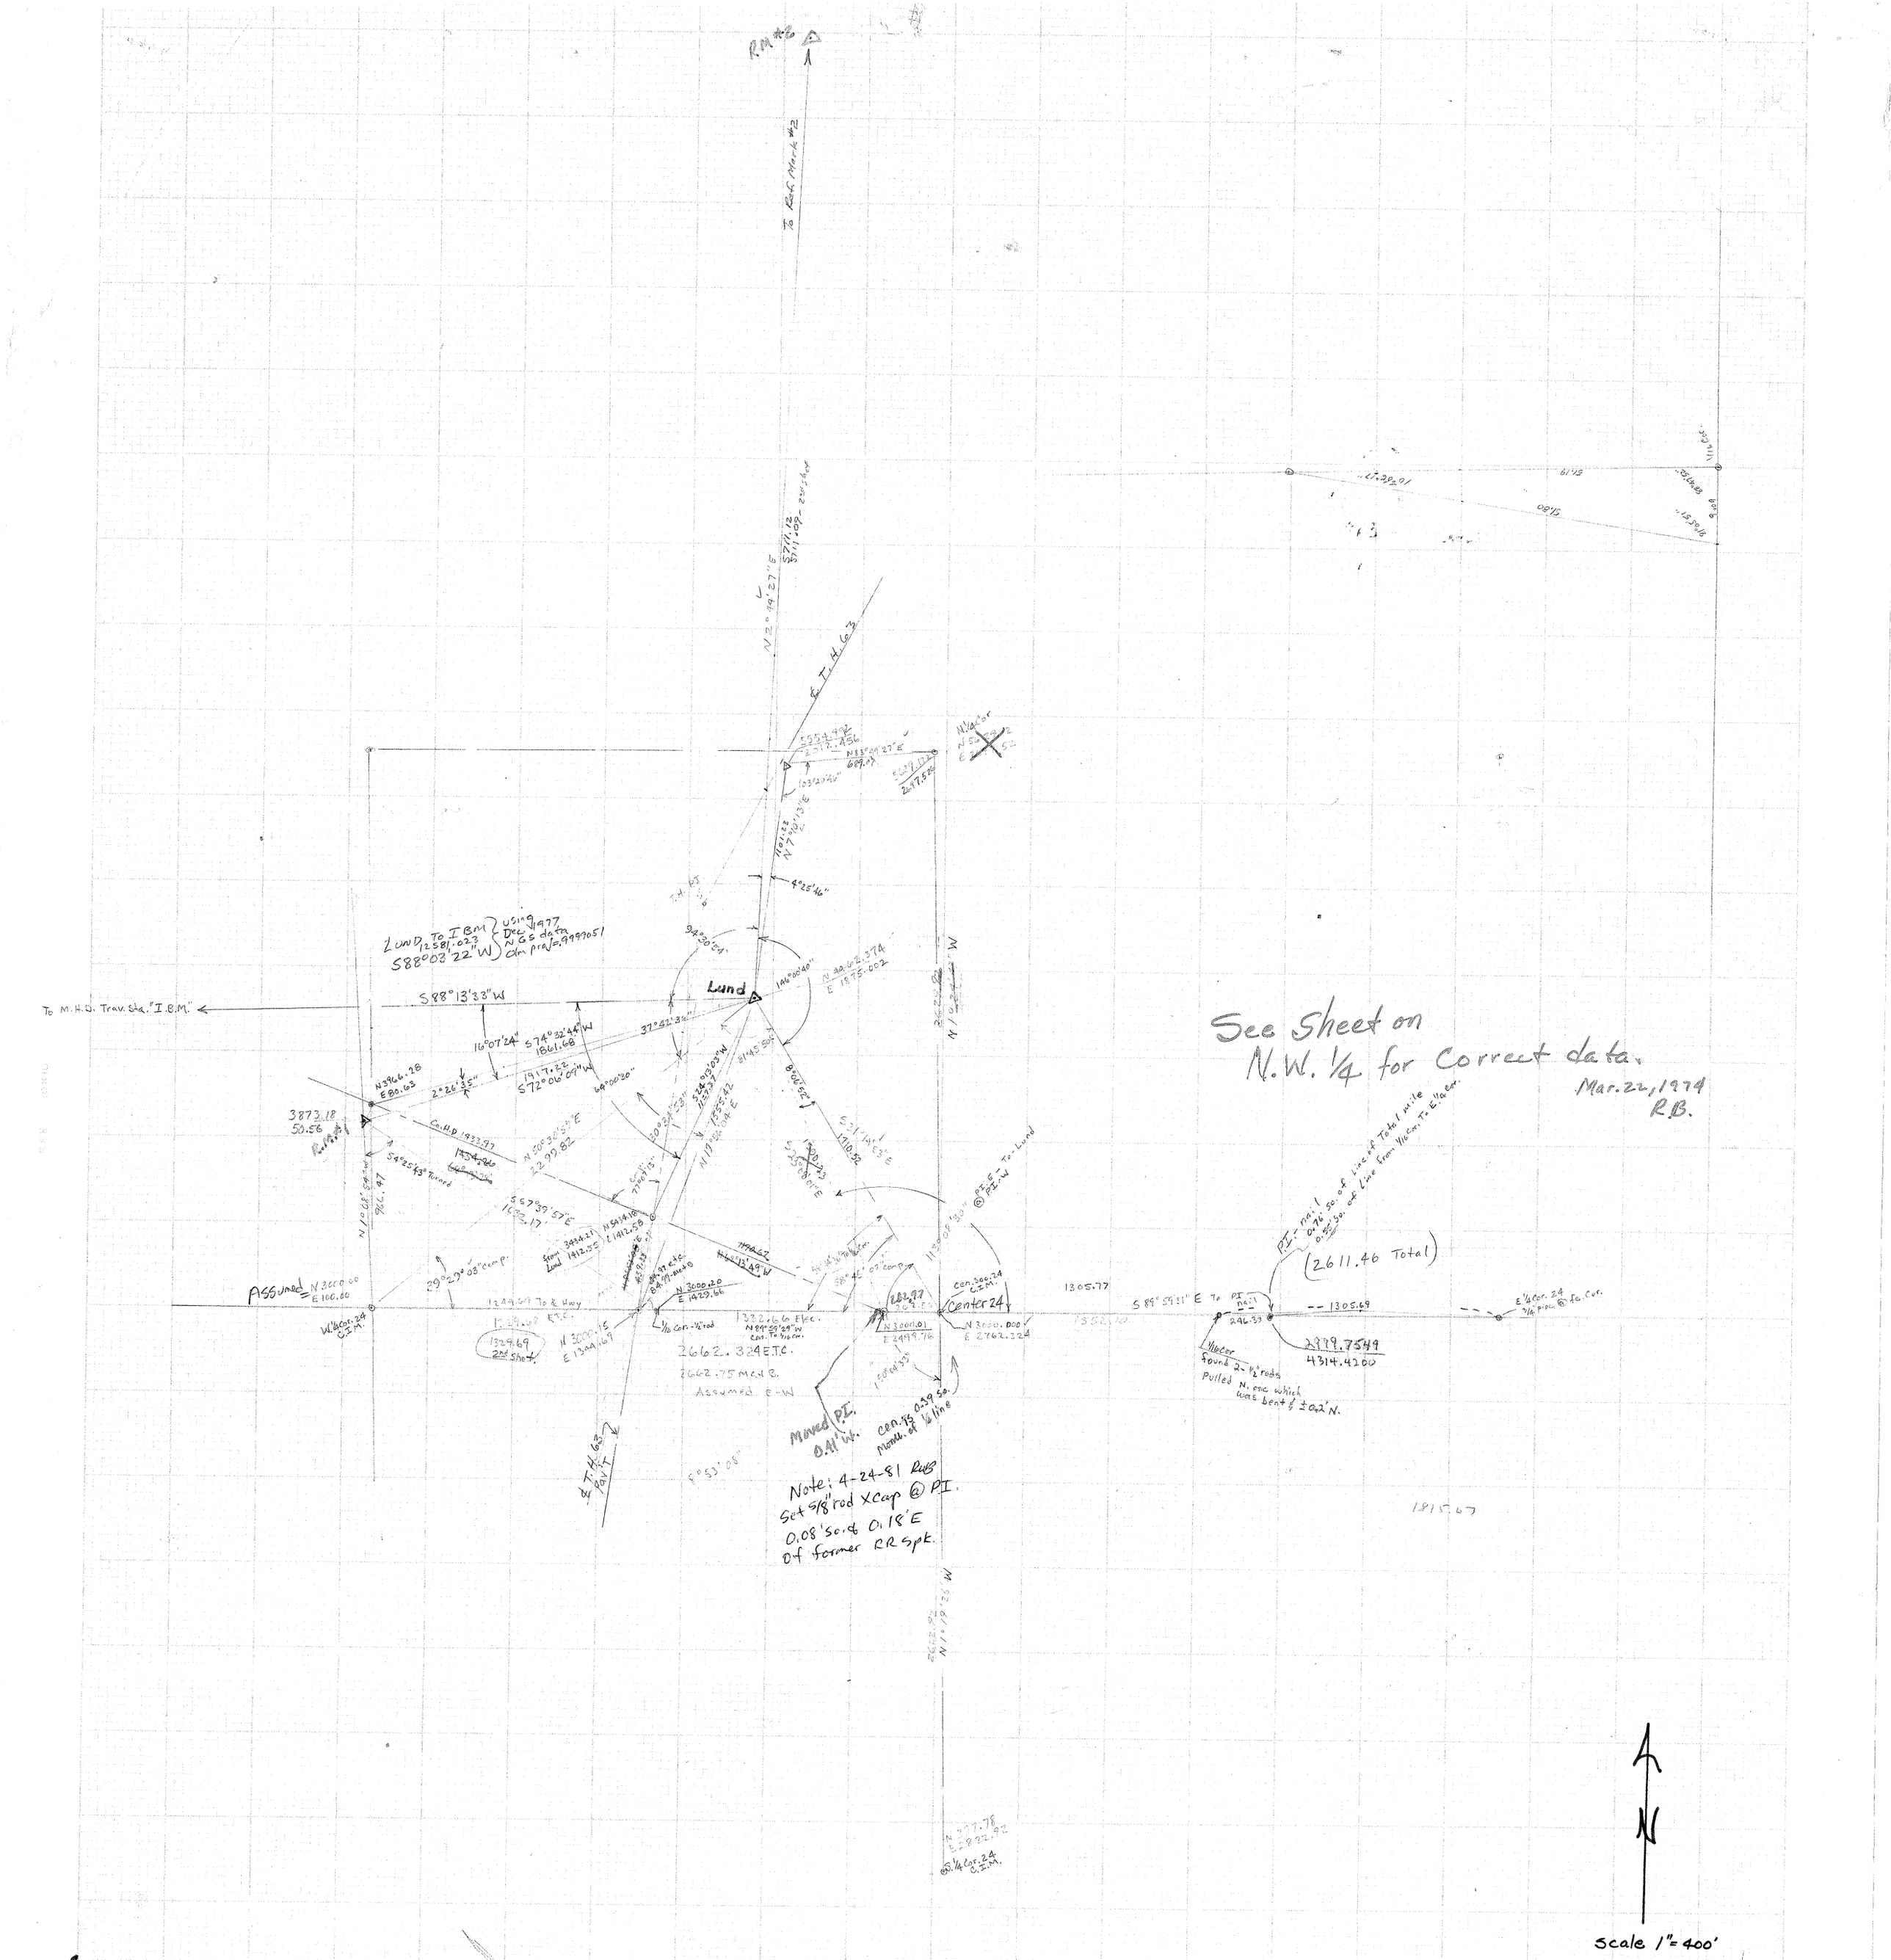


See Sheet on N.W. 1/4 for Correct data.

Mar. 22, 1979
R.B.

Section 24-107-14

Drwg No. 3-48A

3-48A