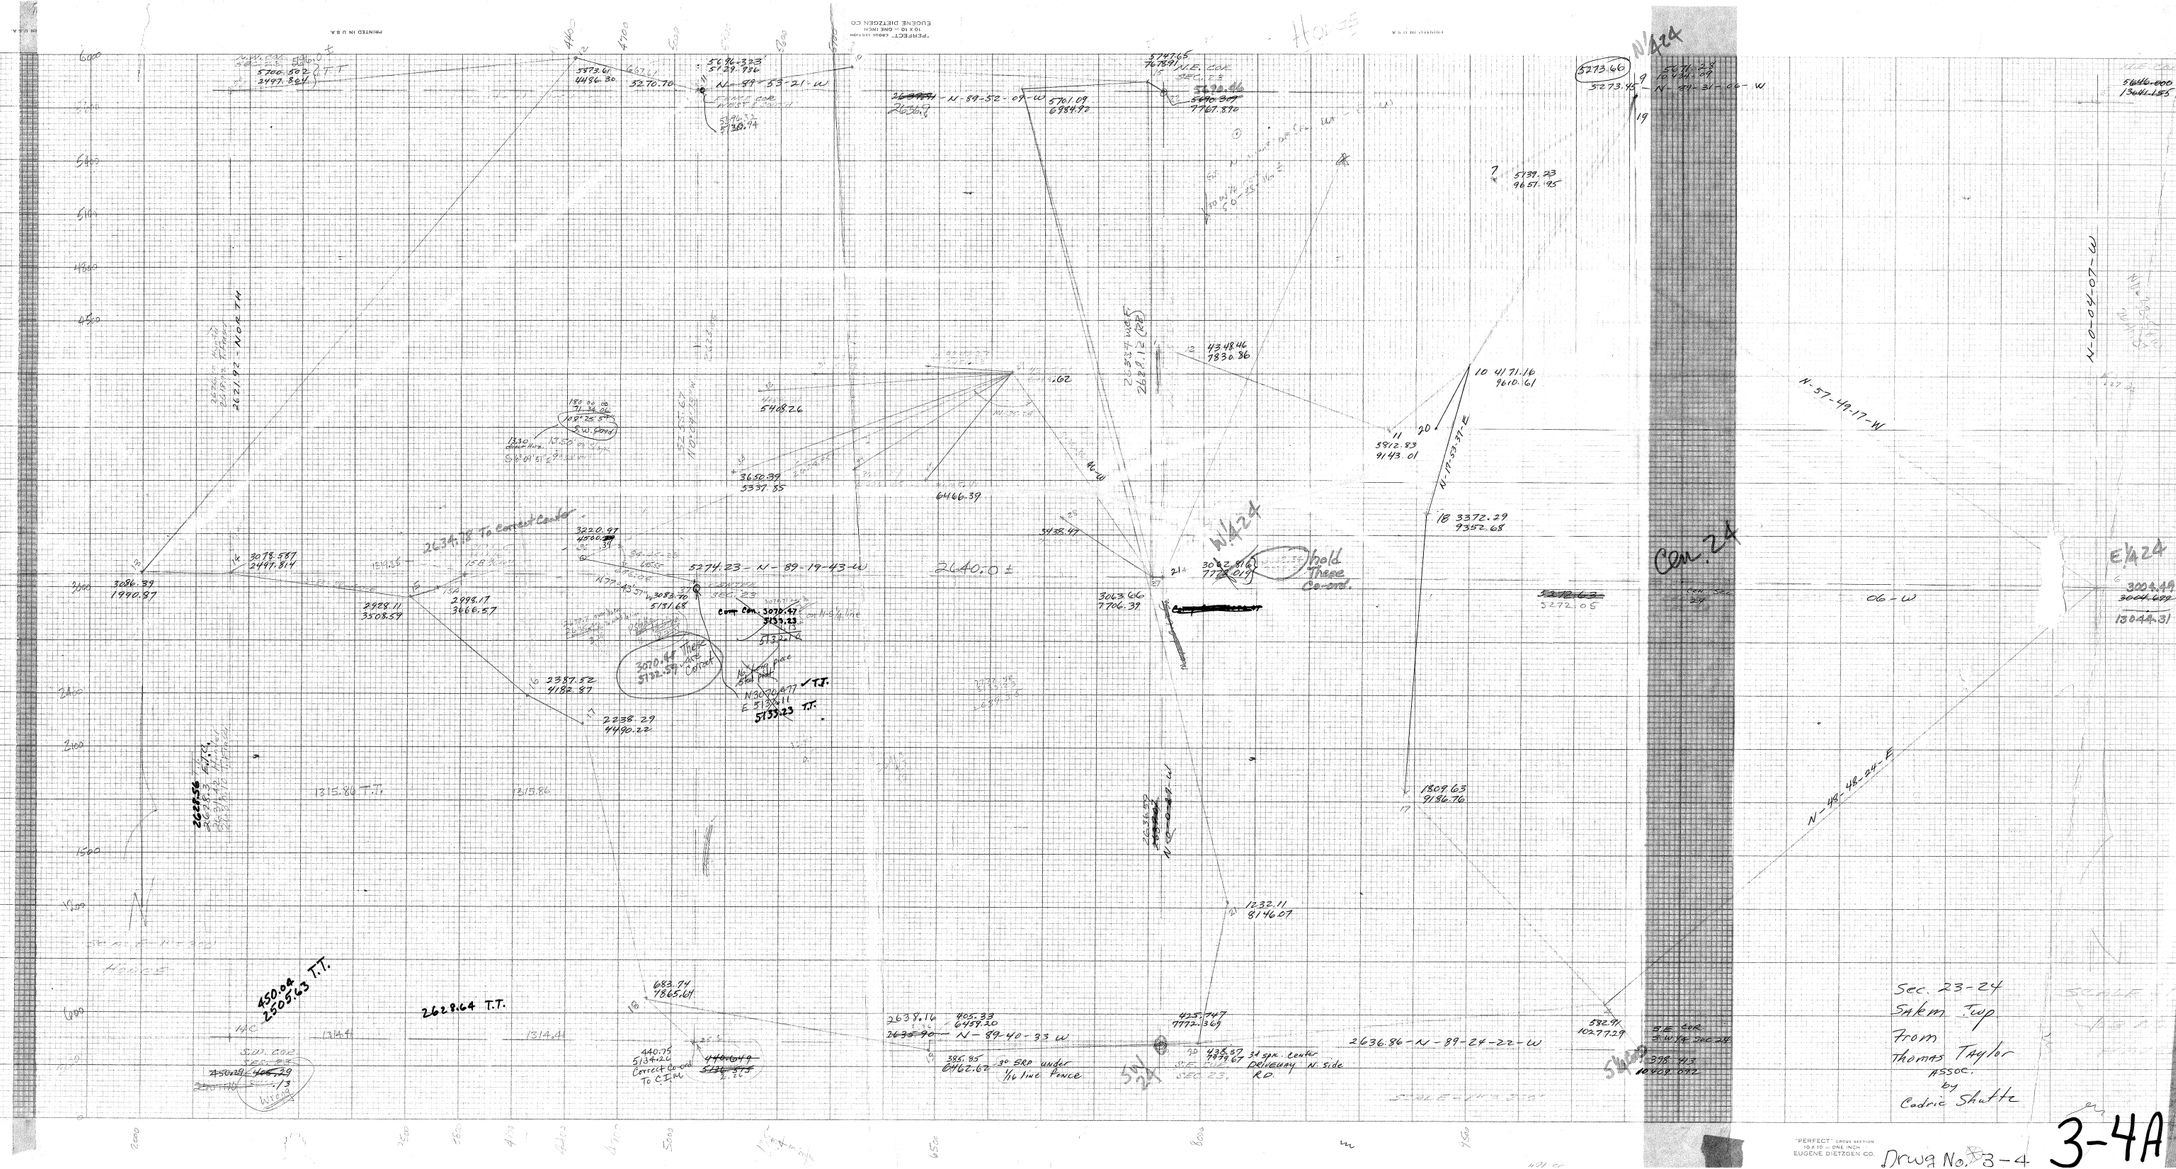

Sec. 23-24
Sakm Twp
From
Thomas Taylor
Assoc.
by
Cedric Shuttz
Drwg No. 3-4
3-4A