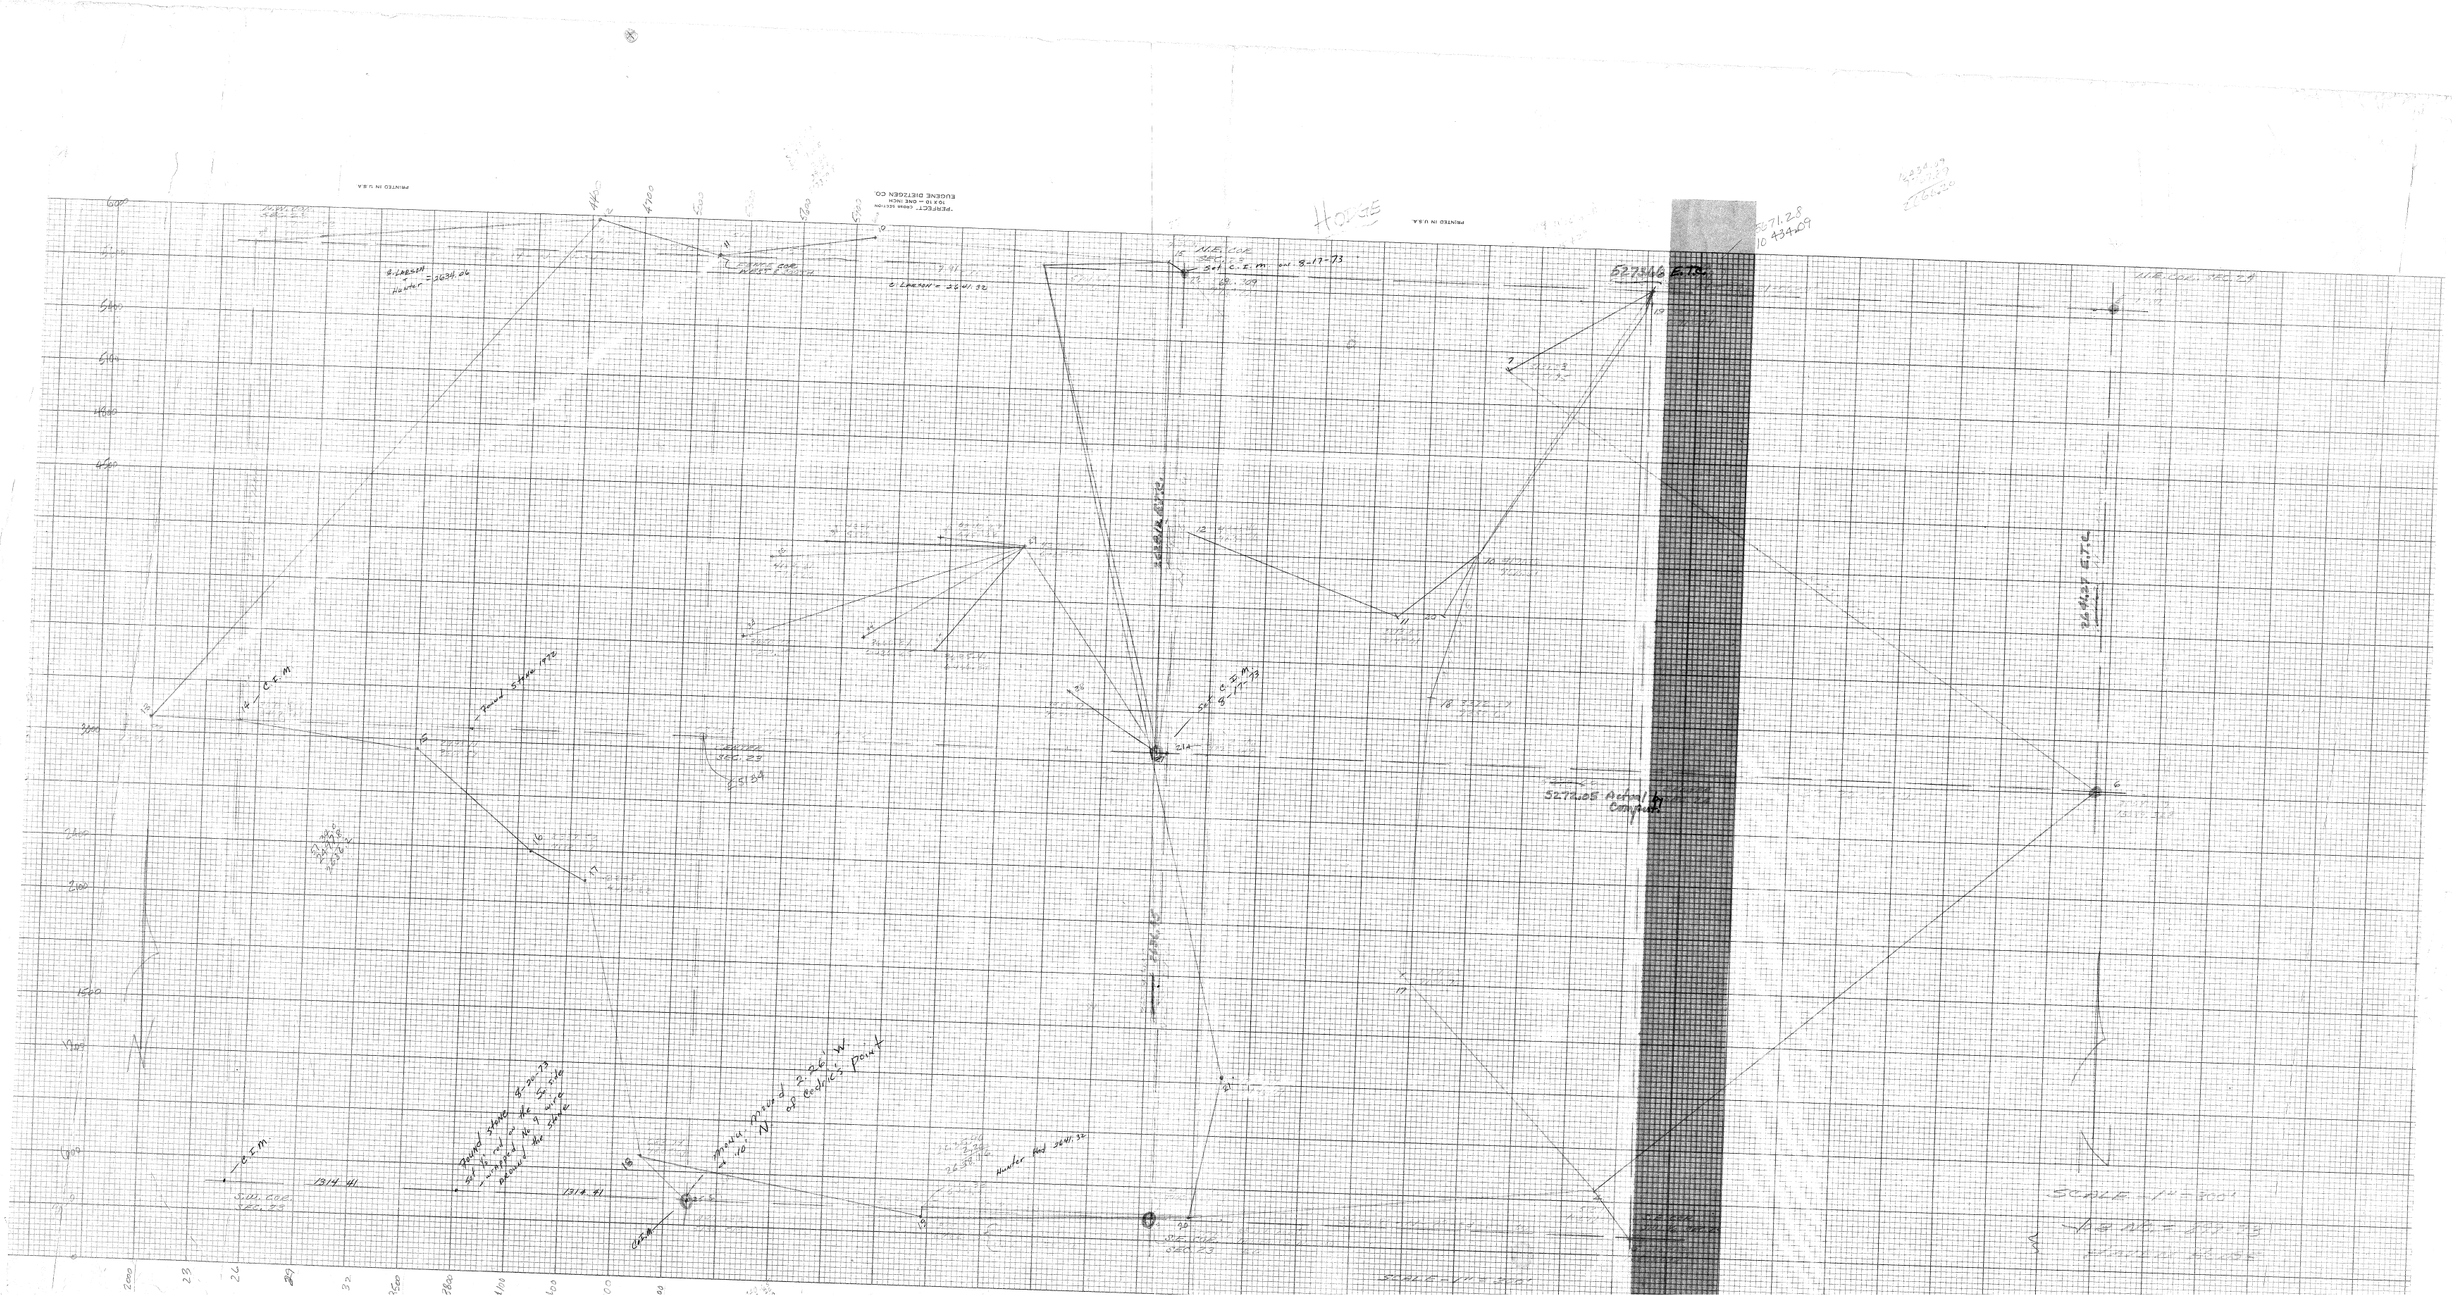

5271.28
10 434459
527446 E.T.C.
Found Stone 1932
C.E.M.
