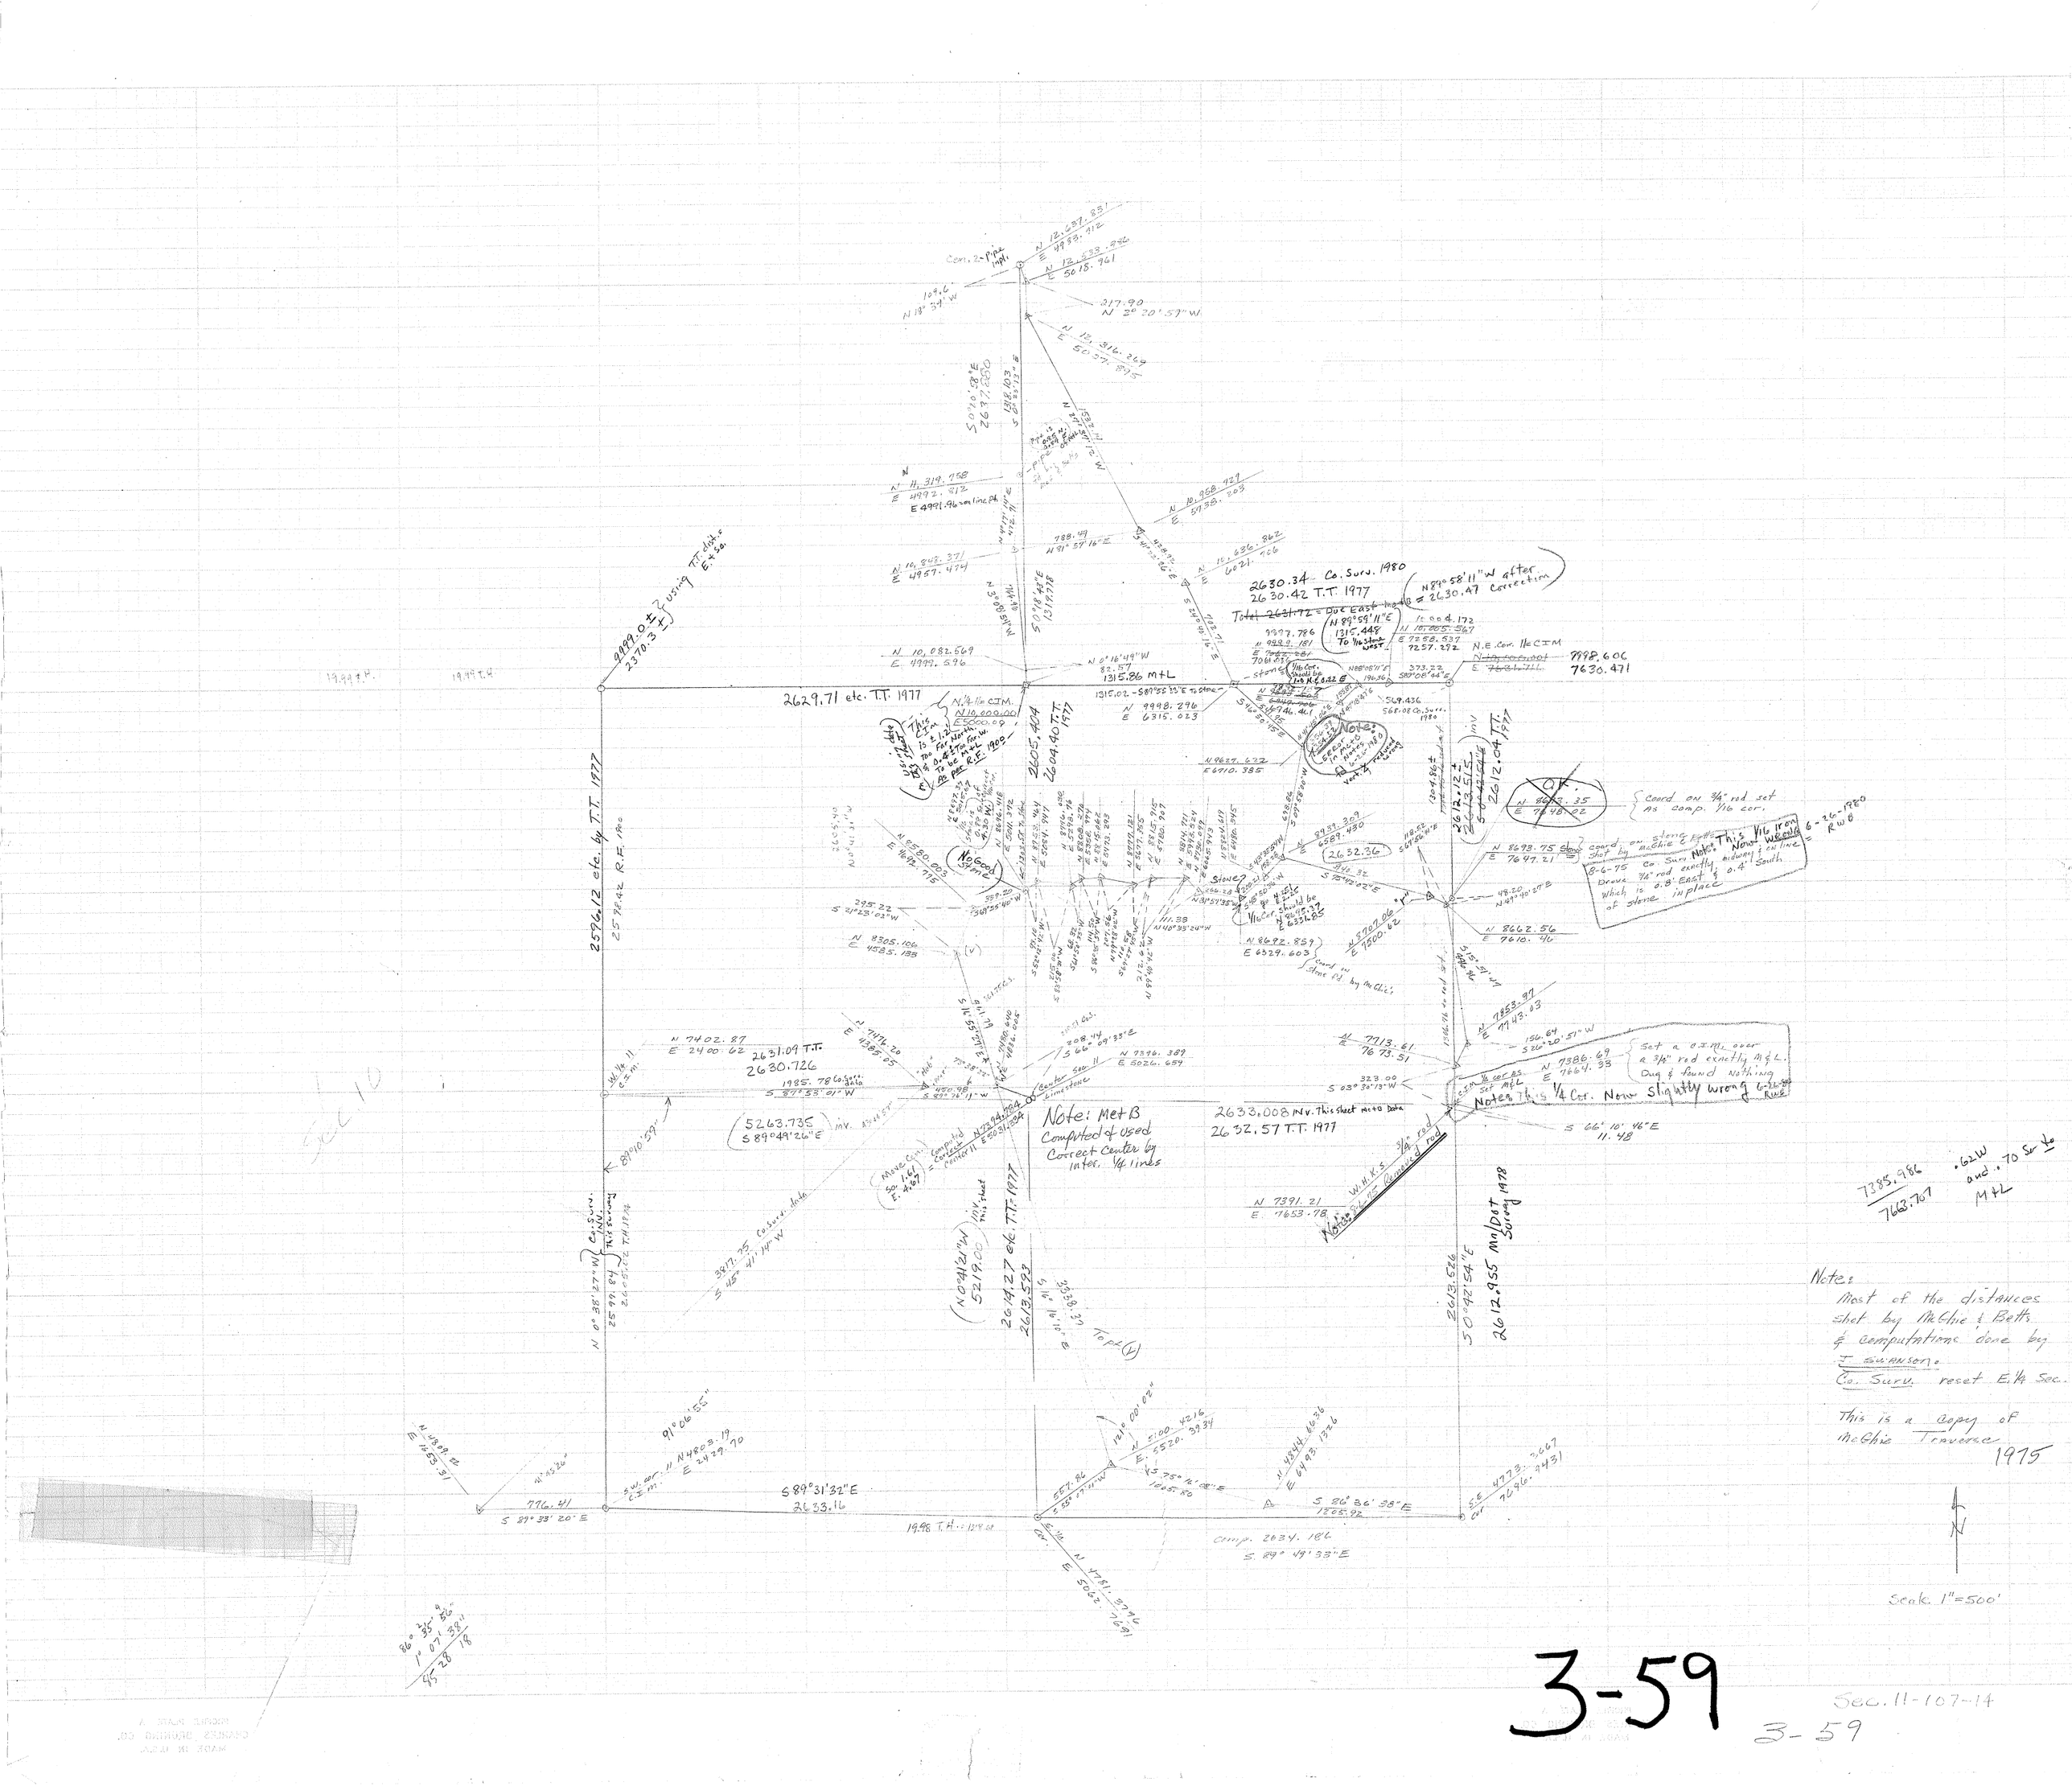

Corn. 2-Pipes Infill
N 12,687.851
E 4983.412
N 12,633.936
E 5018.961
109.6
N 18° 37' W
217.90
N 2° 20' 57" W
N 13,316.269
E 5037.875
S 0°20'58"E
2697.2880
S 1318.103
S 0°25'33"E
N 2°20'57" W
Pipe 2 0.55 E. of Line
N 1,319.768
E 4992.812
E 4991.96 on line Pt
N 10,958.727
E 5038.203
N 0°22'11"E
N 10,845.371
E 4957.474
788.49
N 81° 57' 16" E
S 0°18'47"E
1317.78
N 0°08'11"W
2630.34 Co. Surv. 1980
2630.42 T.T. 1977
N 89°59'11"E
1315.448
To 1/16 stone WEST
N 89°58'11"W after
Correction
N 10,082.569
E 4999.596
N 0°16'49"W
82.57
1315.86 M+L
1315.02 - S 89°55'33"E to stone
N 9998.296
E 6315.023
N 9627.622
E 6710.385
2629.71 etc. T.T. 1977
2605.404
2604.90 T.T. 1977
N.1/4 Cor. CIM.
N 10,000.00
E 5000.09
This CIM is ± 1.1' Too far North & 0.4' Too far W. To be M+L per R.E. 1900
Stone
N 8677.181
E 6271.385
