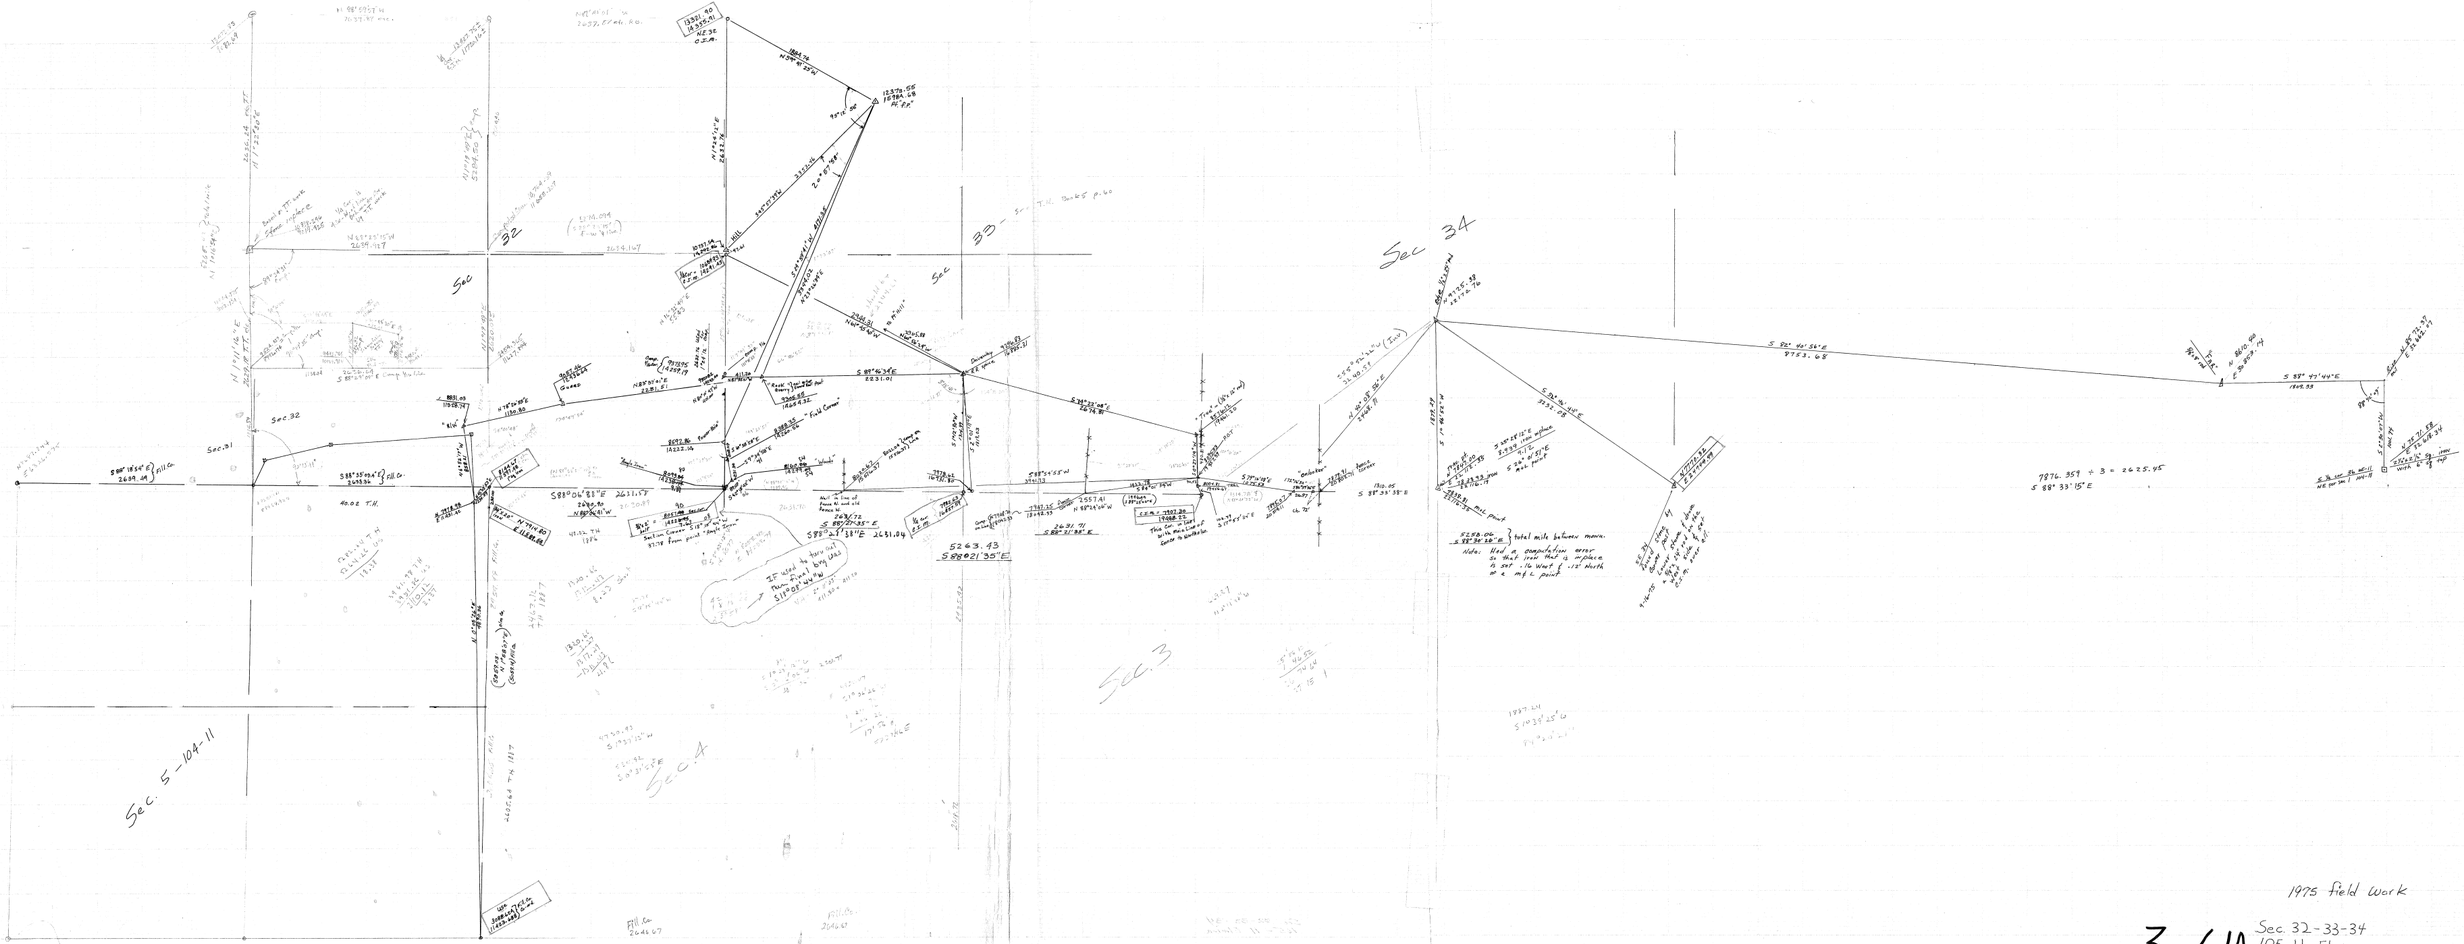

Sec. 32
Sec. 33
Sec 34
Sec. 31
Sec. 5 - 104-11
Sec. 4
Sec. 3
S 88° 33' 15" E
7876.359 ÷ 3 = 2625.45
S 88° 33' 15" E
5263.43
S 88° 21' 38" E 2651.04
S 89° 04' 21" E 2651.69
