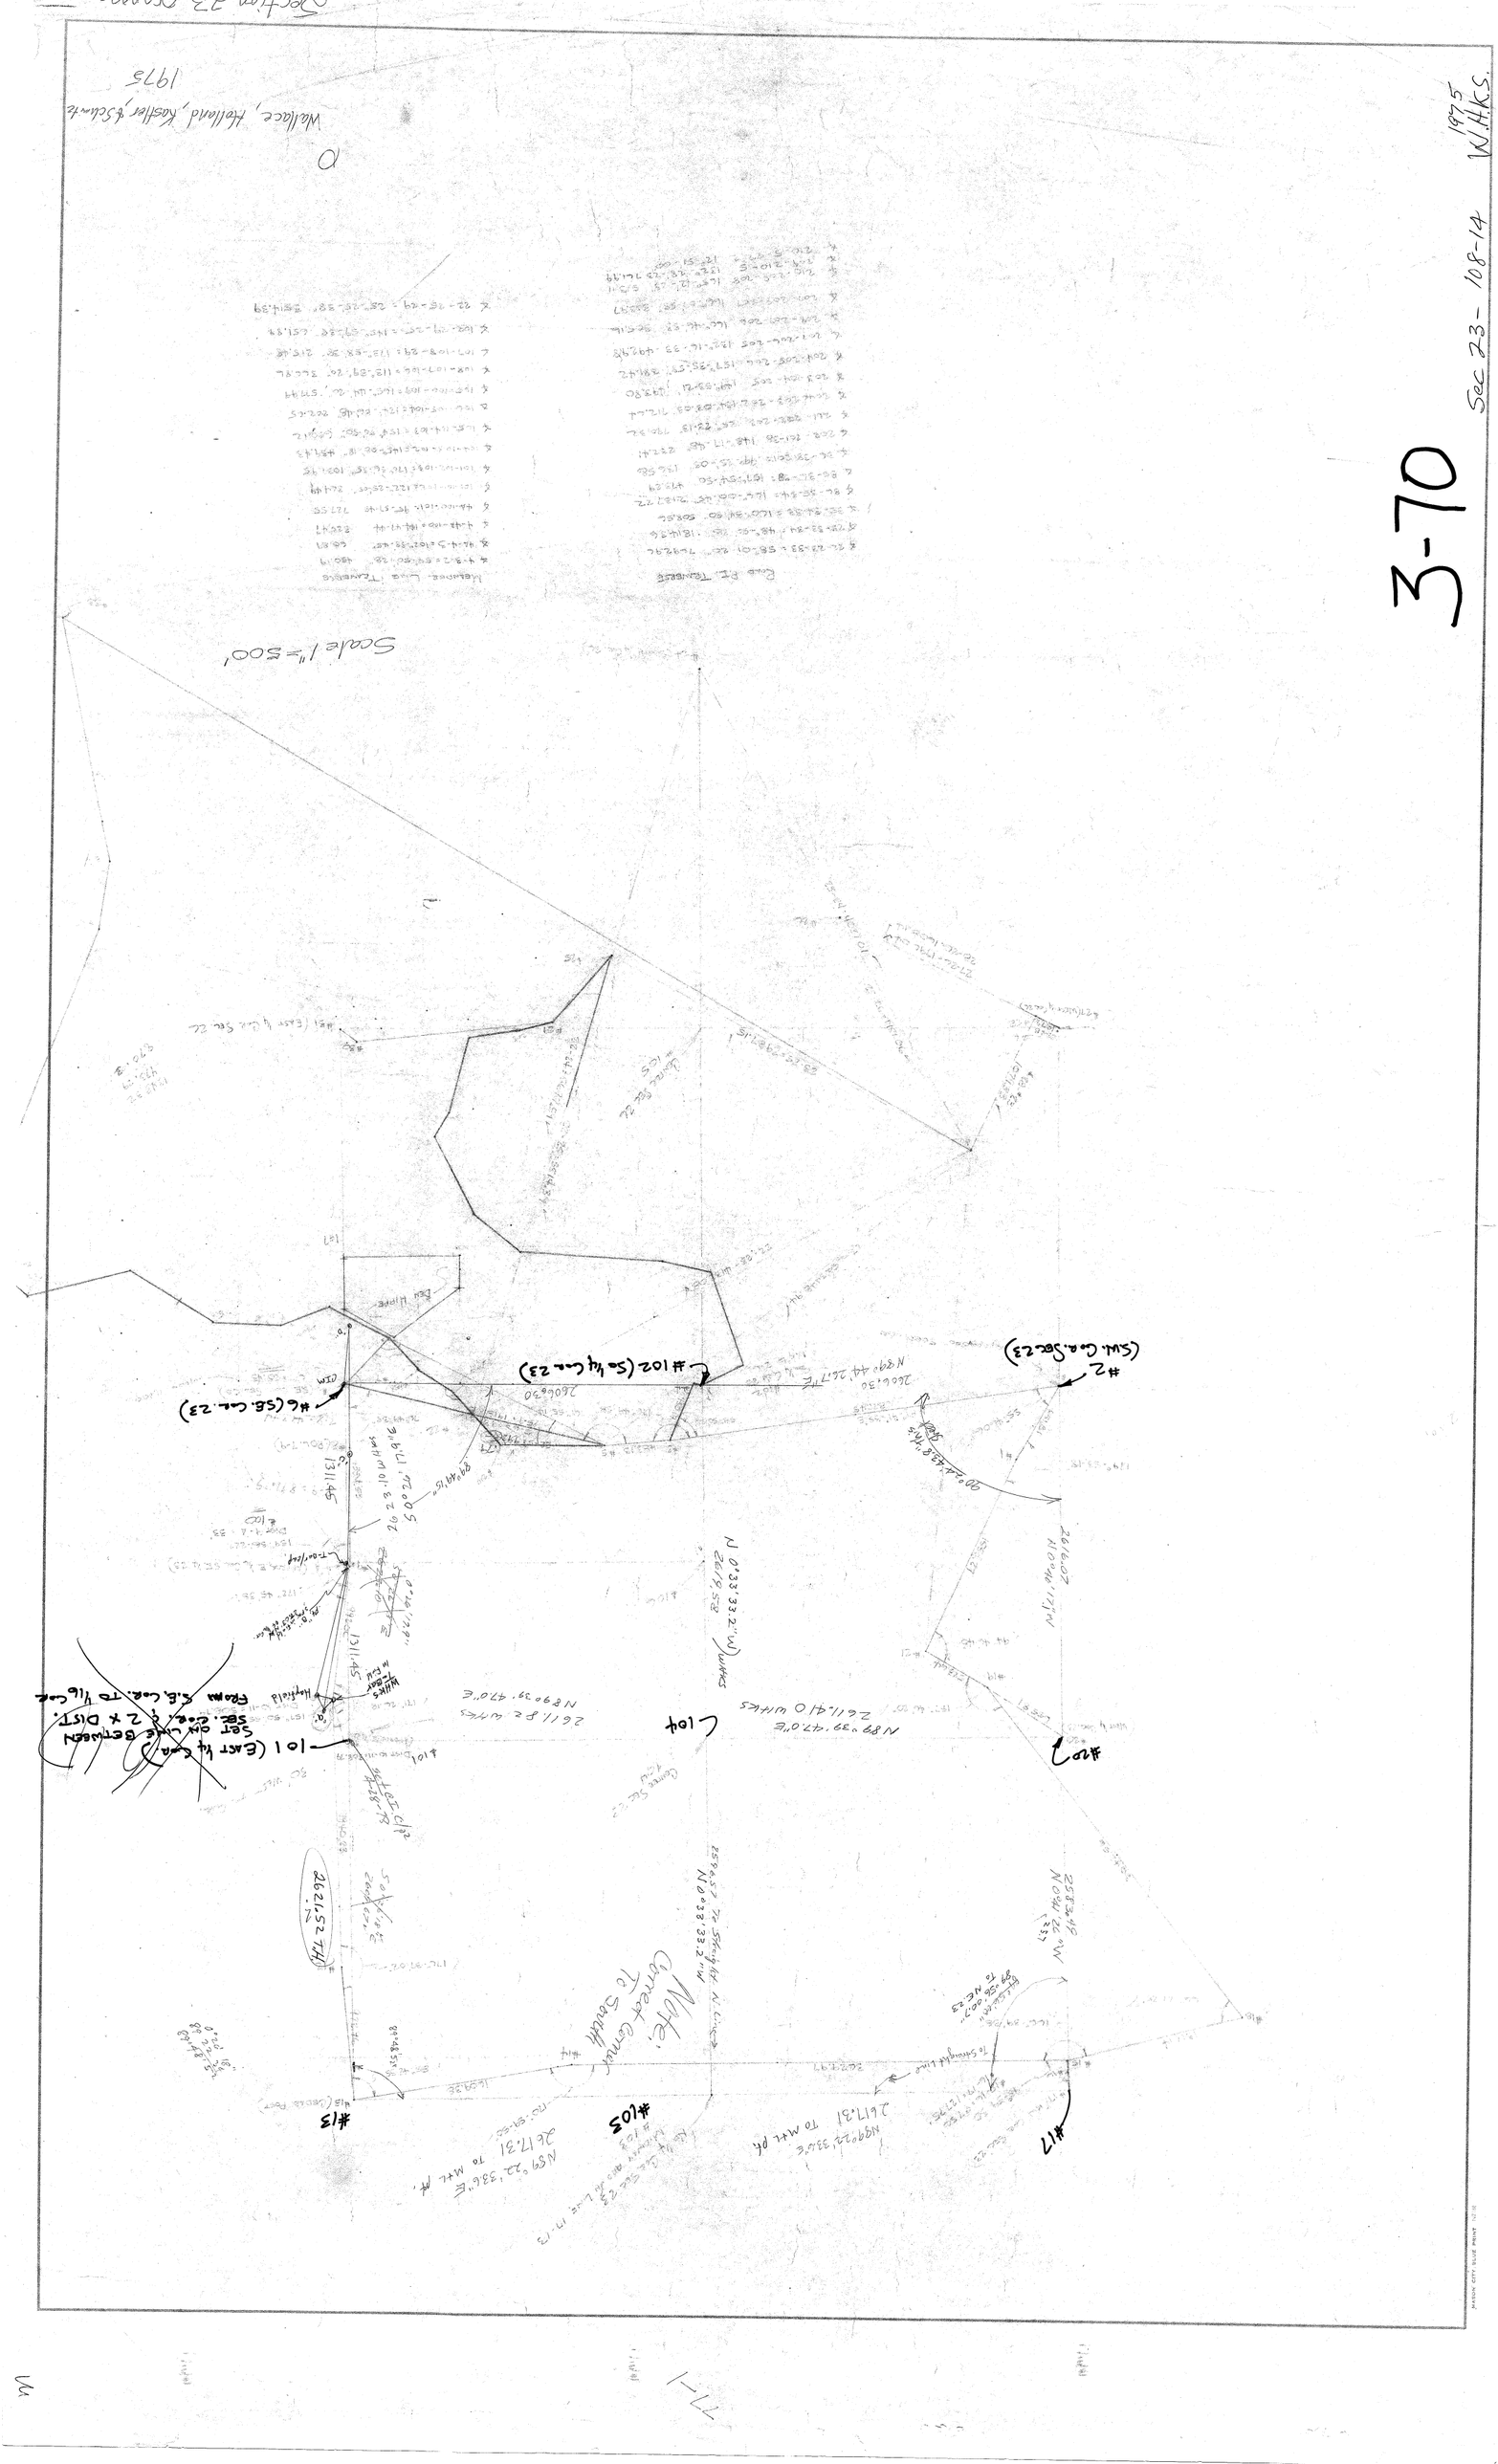

3-70
Sec 23 - 108-14
1975
W.H.K.S.
Scale 1"=500'
#1
#2
#5
#7
#10
#12
#13
#101 (East 1/4 Cor.)
#102 (S. 1/4 Cor. 23)
Set Oak Line Between Sec. Cors. & 2 x Dist. From S.E. Cor. to Ylg. Cor.
Hayfield
White Fence in Line
Center Sec. 23
Line
Center
South
Scale 1"=500'
Wallace, Hetland, Koehler & Schmitz
1973