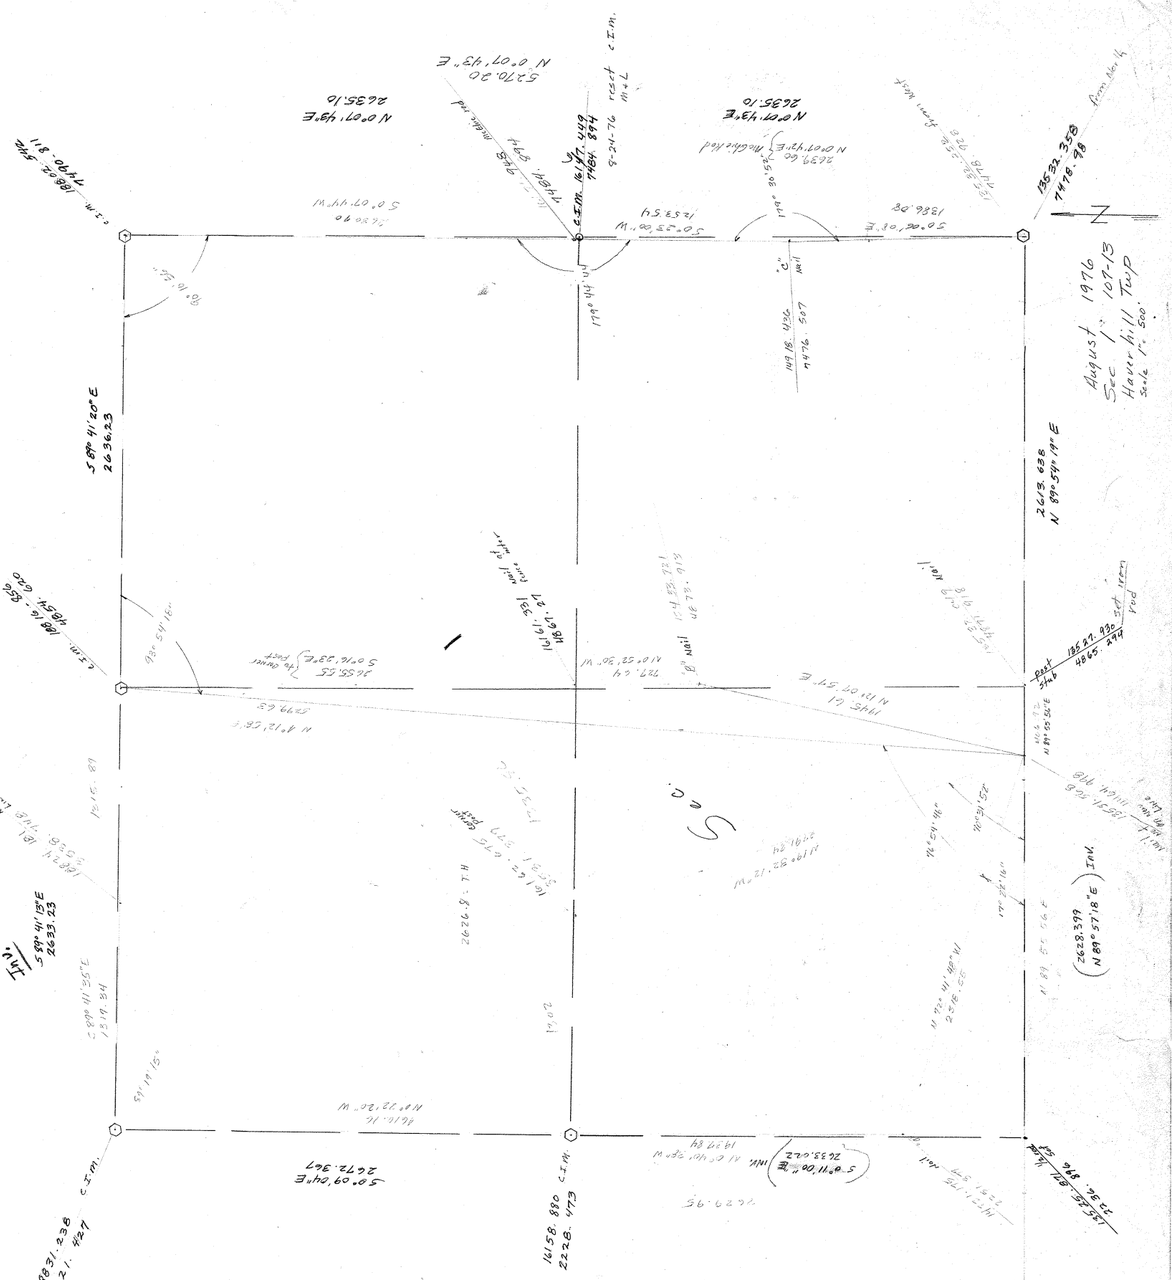

August 1976
Sec 1 : 107-13
Haven Hill Twp
Scale 1" = 500'
N
S 89° 41' 25" E
2636.23
N 89° 54' 19" E
S 89° 41' 25" E
2633.23
S 89° 57' 18" E
2628.39
N 0° 07' 43" E
2635.10
S 0° 07' 43" W
2635.10
S 0° 25' 00" W
1538.08
N 0° 25' 00" E
1538.08
S 89° 09' 04" E
2672.367
