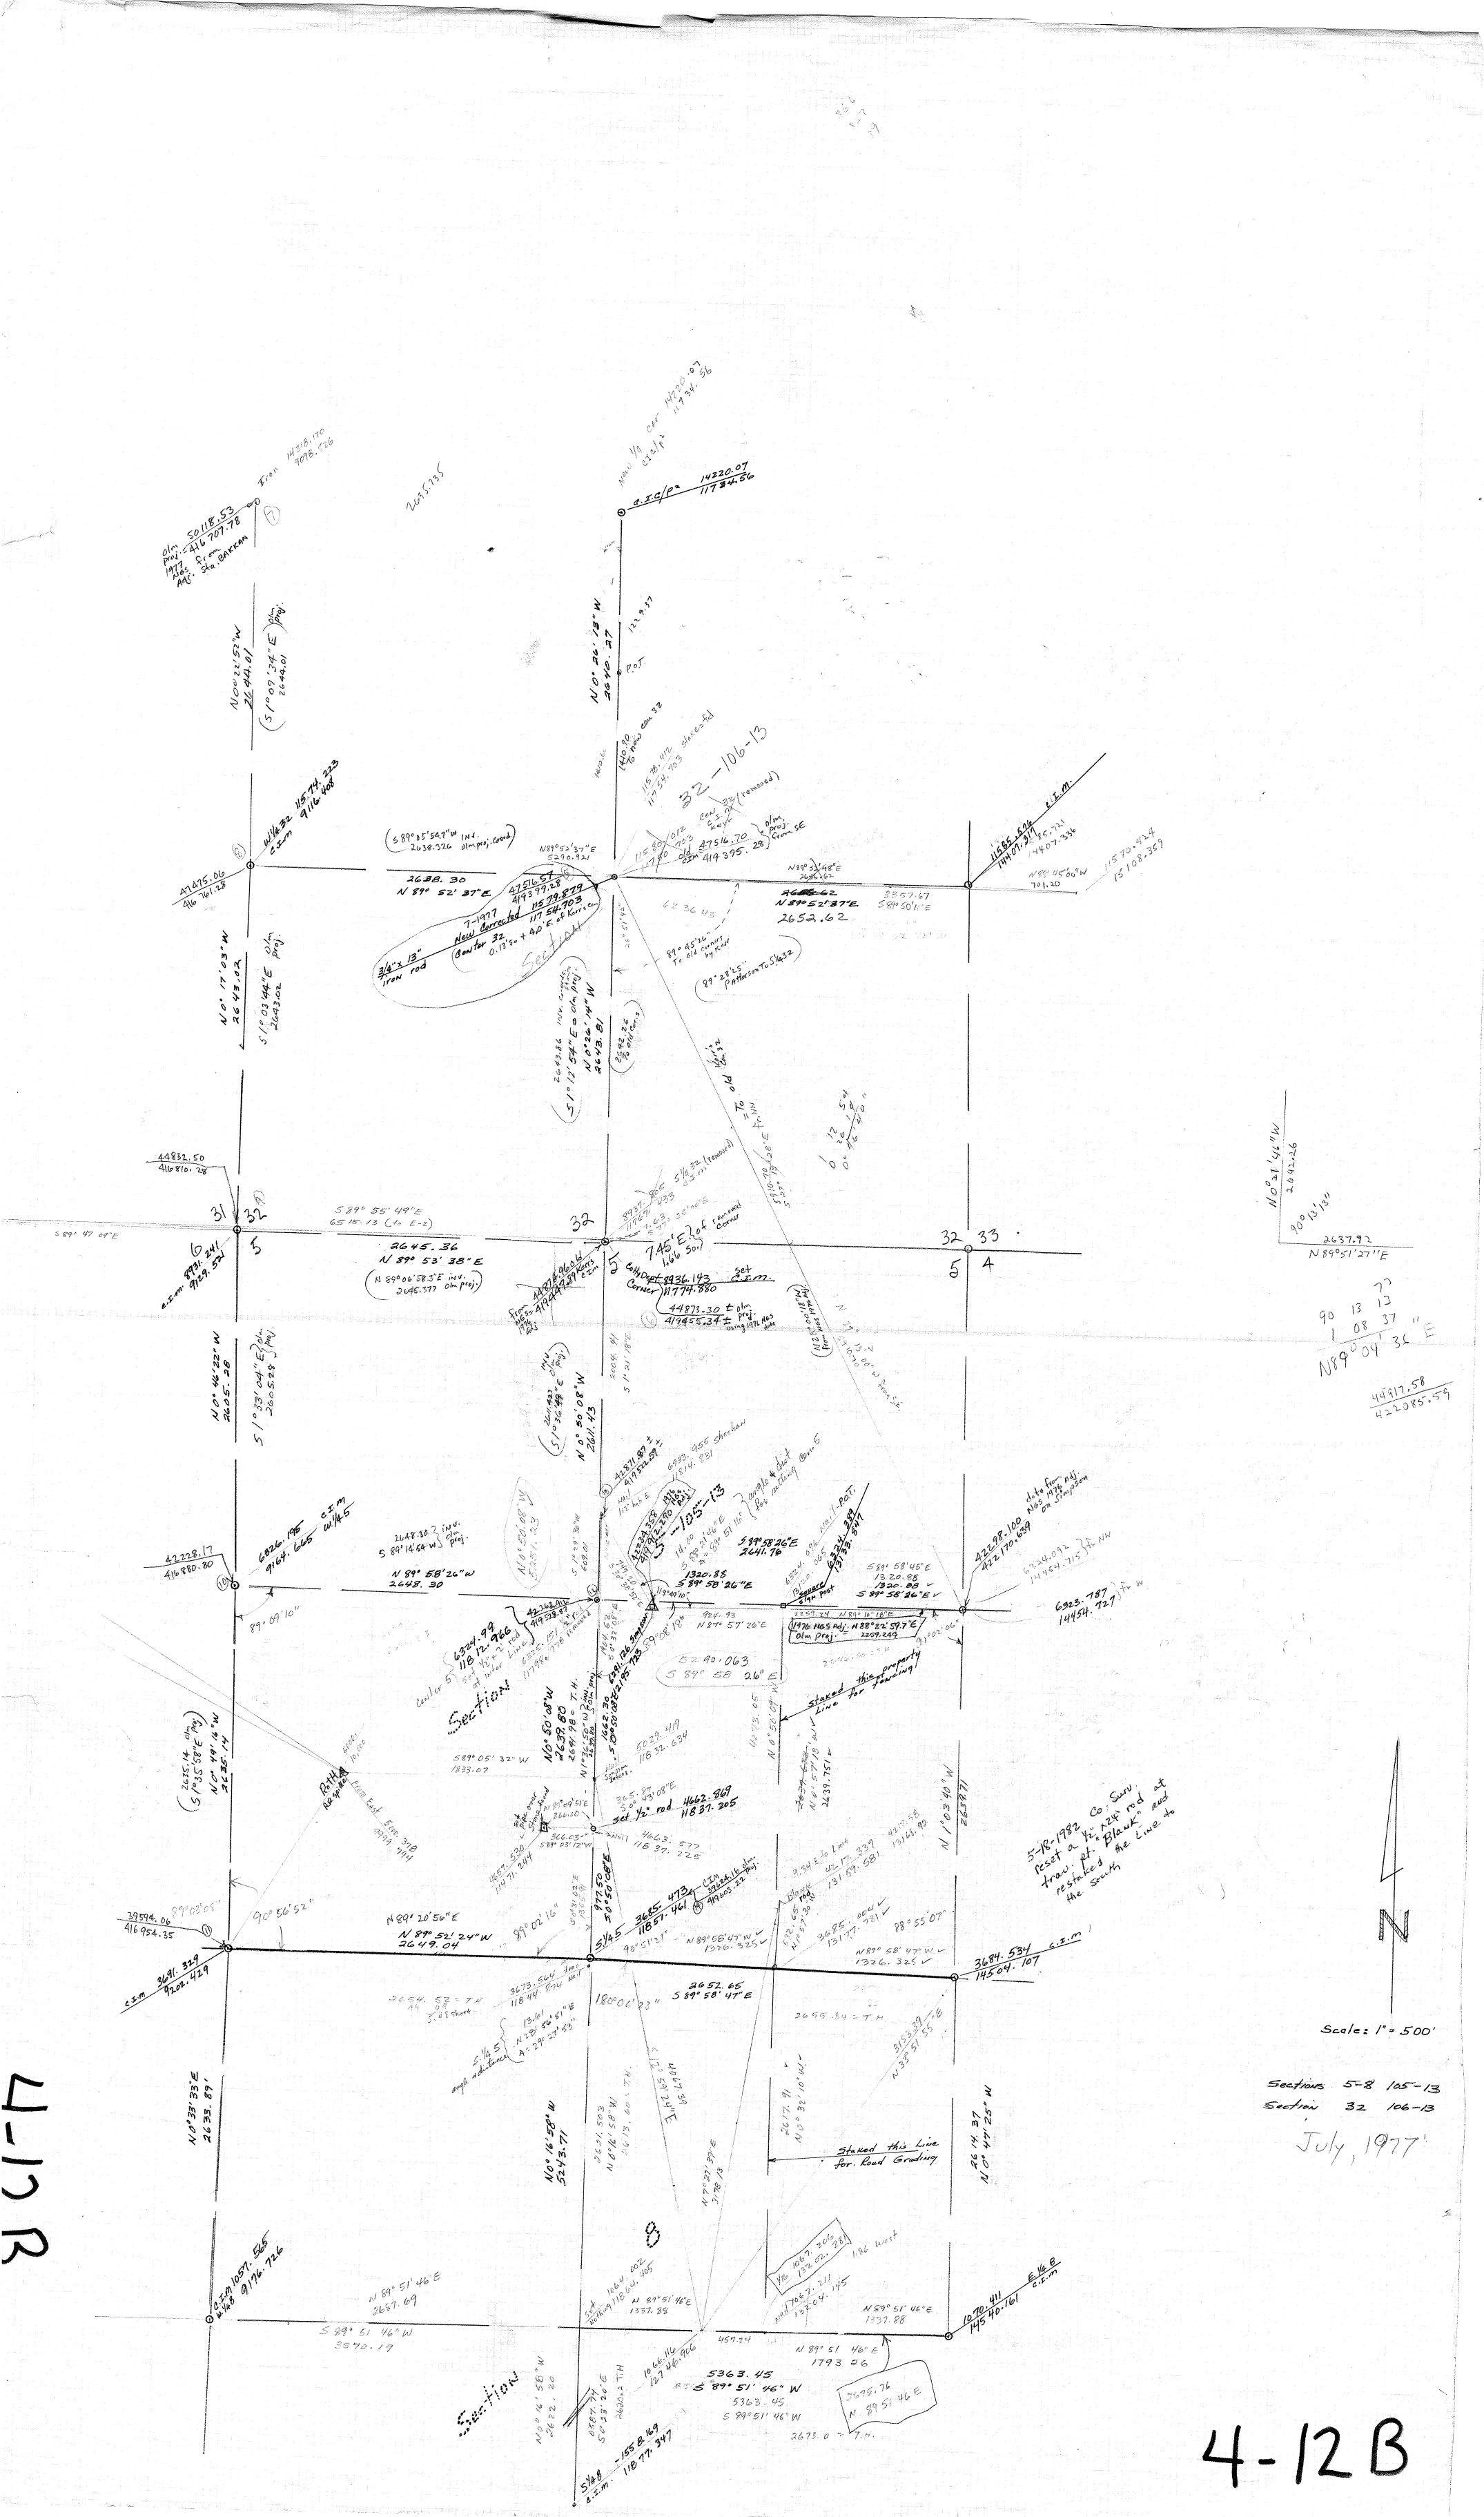

Section
Scale: 1" = 500'
Sections 5-8 105-13
Section 32 106-13
July, 1977
4-12 R
4-12 B