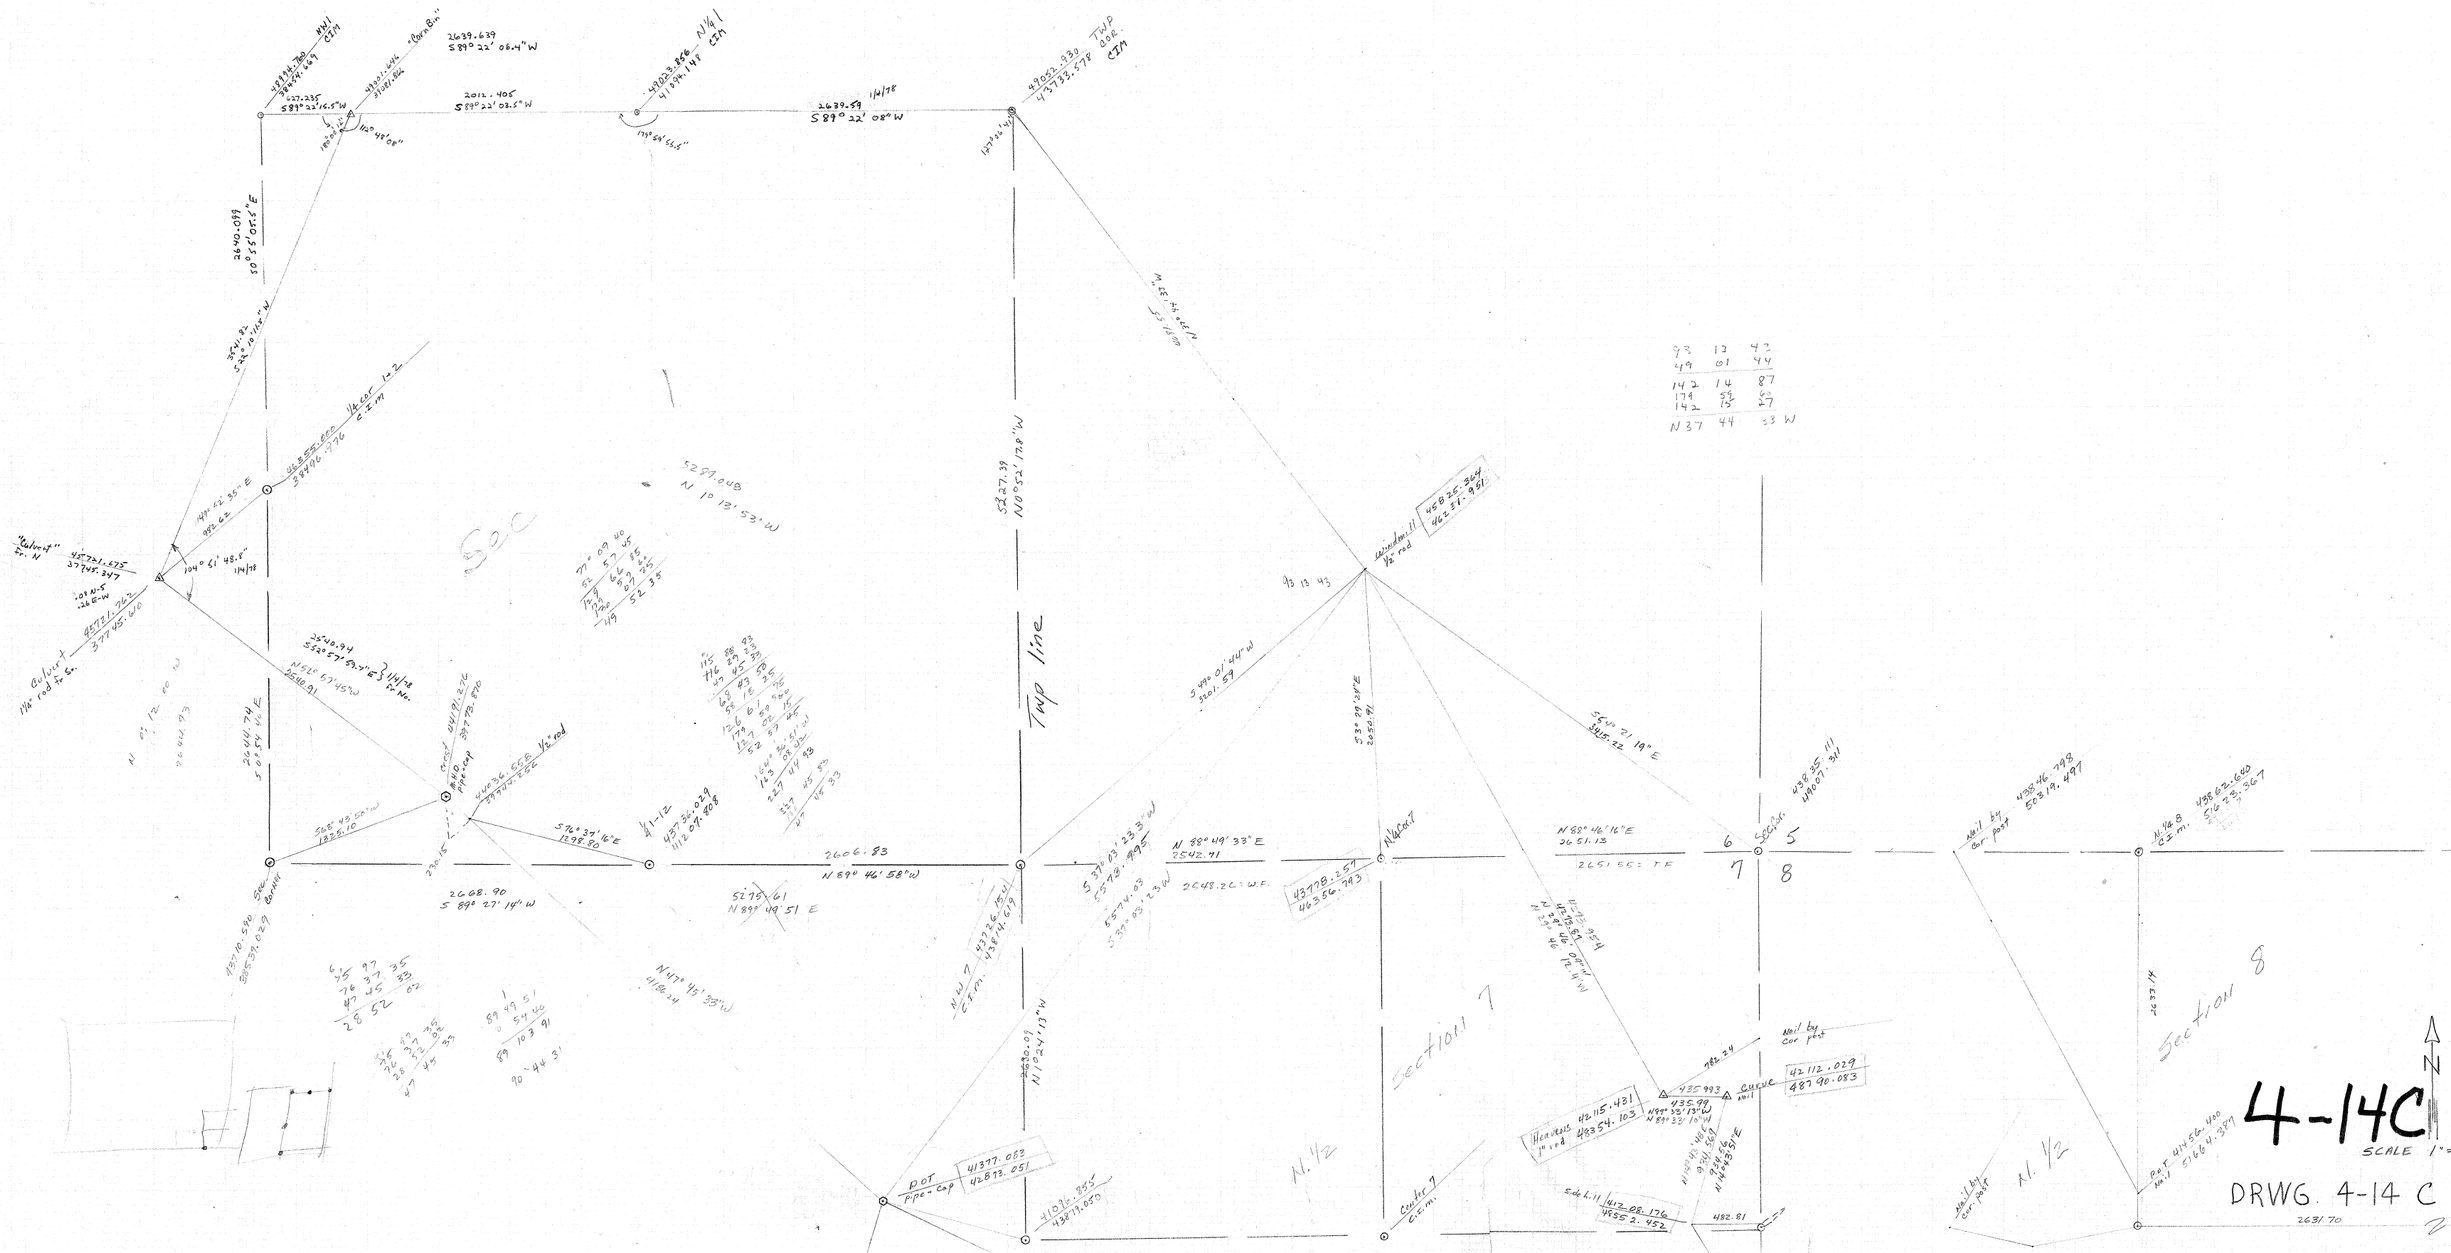

N1/4 cor
CTM
2639.639
S 89° 22' 06.4" W
2012.405
S 89° 22' 08.5" W
N1/4 cor
CTM
2639.59
S 89° 22' 08" W
TWP cor.
CTM
627.235
S 89° 22' 16.5" W
112° 48' 08"
179° 59' 55.5"
2640.089
S 0° 5' 05.5" E
N 0° 12' 00" W
2644.74
S 0° 54' 45" E
N 89° 12' 00" W
2640.94
S 52° 57' 57.7" E
N 52° 57' 57.7" W
2646.91
S 89° 22' 16.5" W
S 16° 37' 16" E
1298.80
S 8° 49' 51" W
1225.10
230.15
2606.83
N 89° 46' 58" W
2668.90
S 89° 27' 14" W
5278.61
N 89° 49' 51" E
N 47° 45' 39" W
4178.24
5291.08
N 1° 12' 53" W
5227.39
N 0° 52' 17.8" W
2630.09
N 1° 24' 13" W
S 37° 03' 23" W
5274.03
S 37° 03' 23" W
N 88° 49' 33" E
2542.71
2648.26' W.F.
N 88° 46' 16" E
2651.13
2651.55' TF
N 89° 46' 16" E
2633.14
N 0° 12' 00" W
2631.70
N 37° 44' 33" W
5311.87
S 52° 10' 15" W
N 49° 42' 33" E
992.62
104° 51' 48"
1/4/98
