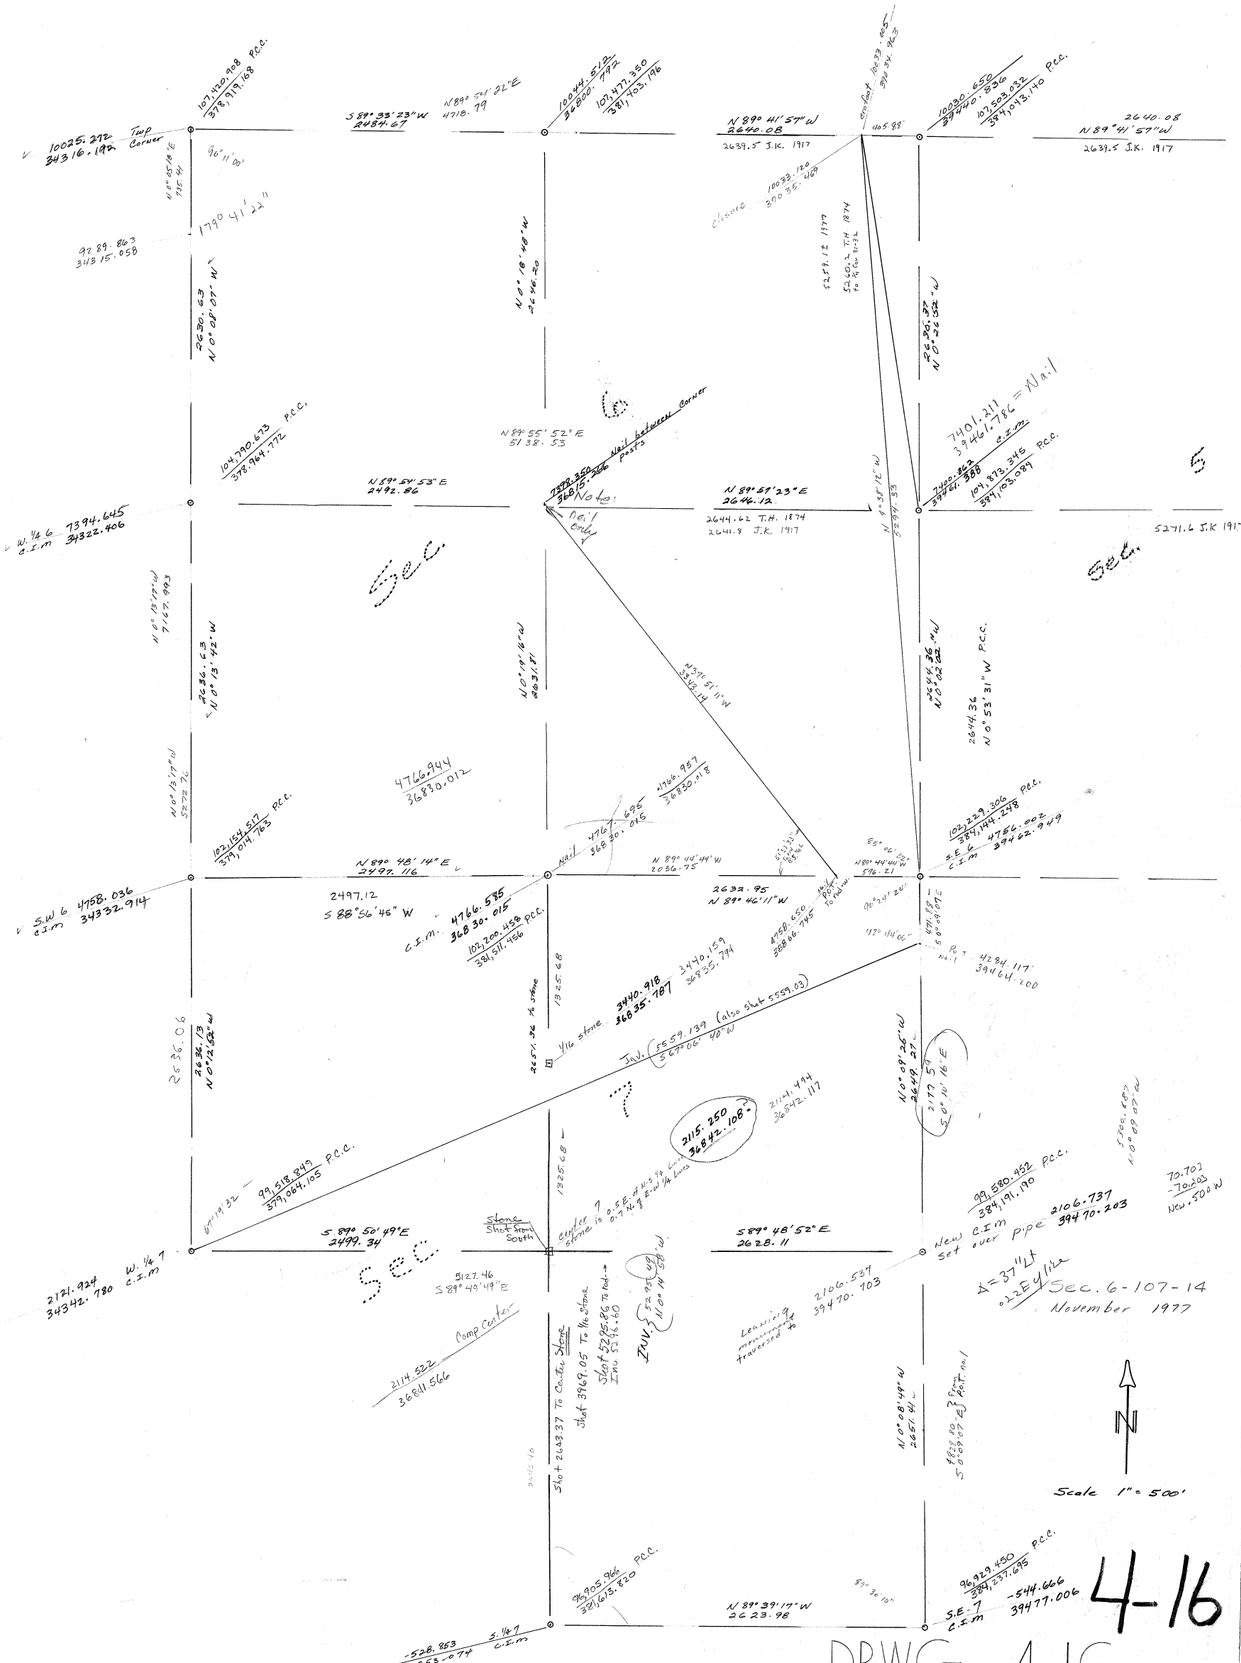

10025.272
343 16.192
Temp Corner
107.1720.908
378,979.168
S 89° 33' 23" W
2684.67
N 89° 58' 32" E
4718.79
104.478.550
32800.7492
107.477.350
381,703.196
N 89° 41' 57" W
2640.08
2639.5 J.K. 1917
10030.650
37440.930
107,503.022
384,013.140 P.C.C.
2640.08
N 89° 41' 57" W
2639.5 J.K. 1917
96° 11' 00"
1790 41' 22"
97 89.869
343 15.058
2630.63
N 0° 08' 07" W
N 0° 18' 48" W
2646.20
Chained 10093.720
390 35.489
2259.12 T.H. 1874
to 4760 W.M.
2646.37
N 0° 08' 32" W
104.790.675
378,969.772 P.C.C.
N 89° 55' 52" E
5138.53
N 89° 54' 53" E
2492.86
N 89° 51' 23" E
2646.12
2644.62 T.H. 1874
2641.8 J.K. 1917
7410.211
39461.786 = Wal
C.I.m
104,473.346
384,103.089 P.C.C.
5271.6 J.K. 1917
W 1/16 C.I.m
7394.645
343 22.906
N 0° 18' 17" W
2639.83
N 0° 13' 42" W
2636.63
N 0° 02' 32" W
2642.36
N 0° 53' 31" W P.C.C.
2644.36
N 0° 53' 31" W
102.164.617
379,014.765 P.C.C.
4766.944
36830.012
N 89° 48' 14" E
2497.116
4766.987
368 30.095
N 89° 44' 49" W
2036.75
4766.987
368 30.018
N 89° 44' 49" W
2036.75
102.229.306
384,149.248 P.C.C.
4756.002
384 22.949
S.W 6 C.I.m
4758.036
343 32.914
2497.12
S 88° 56' 46" W
C.I.m 4766.585
368 30.015
102.704.458 P.C.C.
381,511.486
2632.95
N 89° 46' 11" W
4766.650
368 30.795
N 89° 44' 49" W
176.21
42° 14' 00"
4294.117
394 64.400
2636.06
2636.13
N 0° 12' 52" W
3440.159
368 35.744
3440.918
368 35.787
1/16 stone
Inv. 5559.139
S 67° 06' 40" W
(also SW4 5559.83)
1925.68
N 0° 09' 26" W
2649.37
S 0° 10' 16" E
2173.59
2121.924
343 42.780
W 1/4 7 C.I.m
99.218.849
379,069.105 P.C.C.
2115.250
368 32.108
2141.494
368 42.117
99.580.452
384,191.190
2106.737
394 70.203
S 89° 50' 49" E
2499.34
Stone Shot from South
S 89° 48' 52" E
2628.11
New set C.I.m over pipe
Δ = 37° 11' A
0.12 E 1/12
Sec. 6-107-14
November 1977
5127.46
S 89° 49' 49" E
Temp Center
2114.527
368 11.566
Shot 3969.05 To Ctr. Stone
Shot 5278.80 To Ref. Inv. 5576.60
2106.537
394 70.703
N 0° 08' 49" W
2651.41
Scale 1" = 500'
-528.853
368 55.074
S. 1/4 7 C.I.m
N 89° 39' 17" W
2623.98
96.929.450
384,237.695 P.C.C.
-544.666
39477.006
S.E. 7 C.I.m
4-16
DRWG. 4-16