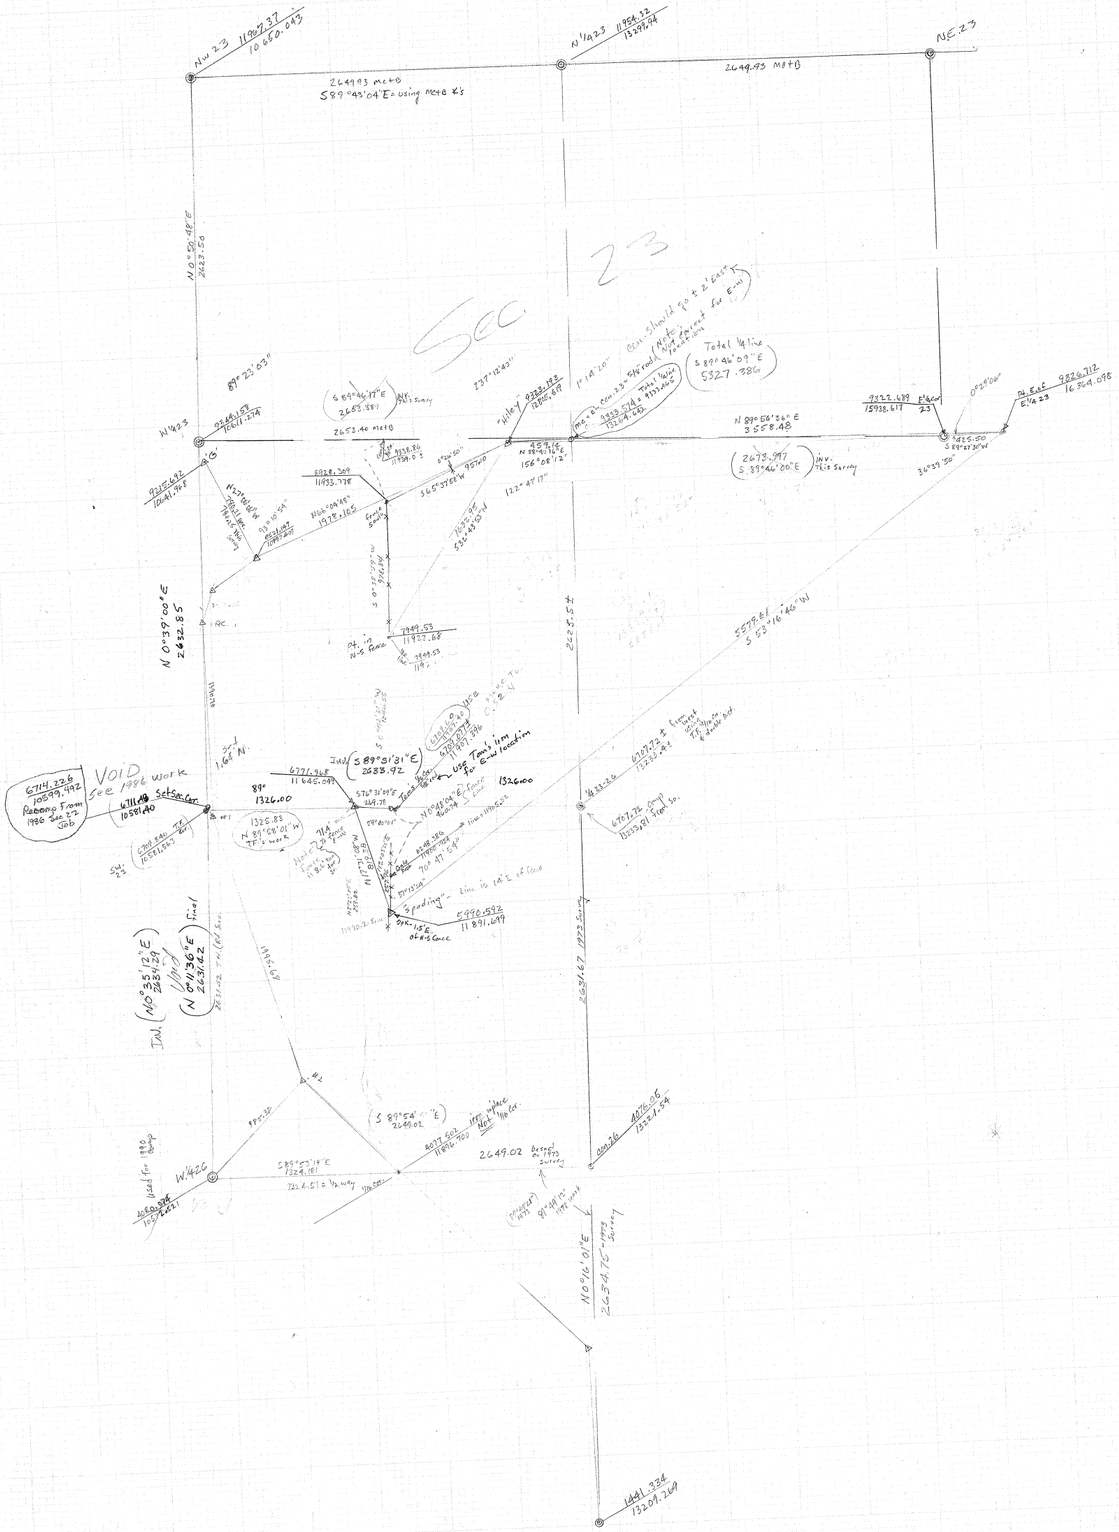

NW 23
N 1/4 23
NE 23
2649.93 M+B
S 89°43'04" E using M+B's
N 0°59'48" E
2623.50
Sec. 23
S 89°23'03" E
2653.40 M+B
N 1/4 23
N 89°56'33" E
3558.48
(2673.997 S 89°46'20" E)
INV. 7 Lk Survey
S 89°46'09" E
Total 1/4 line
1°14'20"
237°10'23"
122°47'17"
156°08'12"
565°57'08" W
N 0°39'00" E
5578.86
S 53°16'46" W
S 89°51'31" E
2633.92
6777.968
11645.049
1326.00
570°33'00" E
N 89°28'01" W
1325.83
Found 2.9 Fence
Set 2.9 Fence
