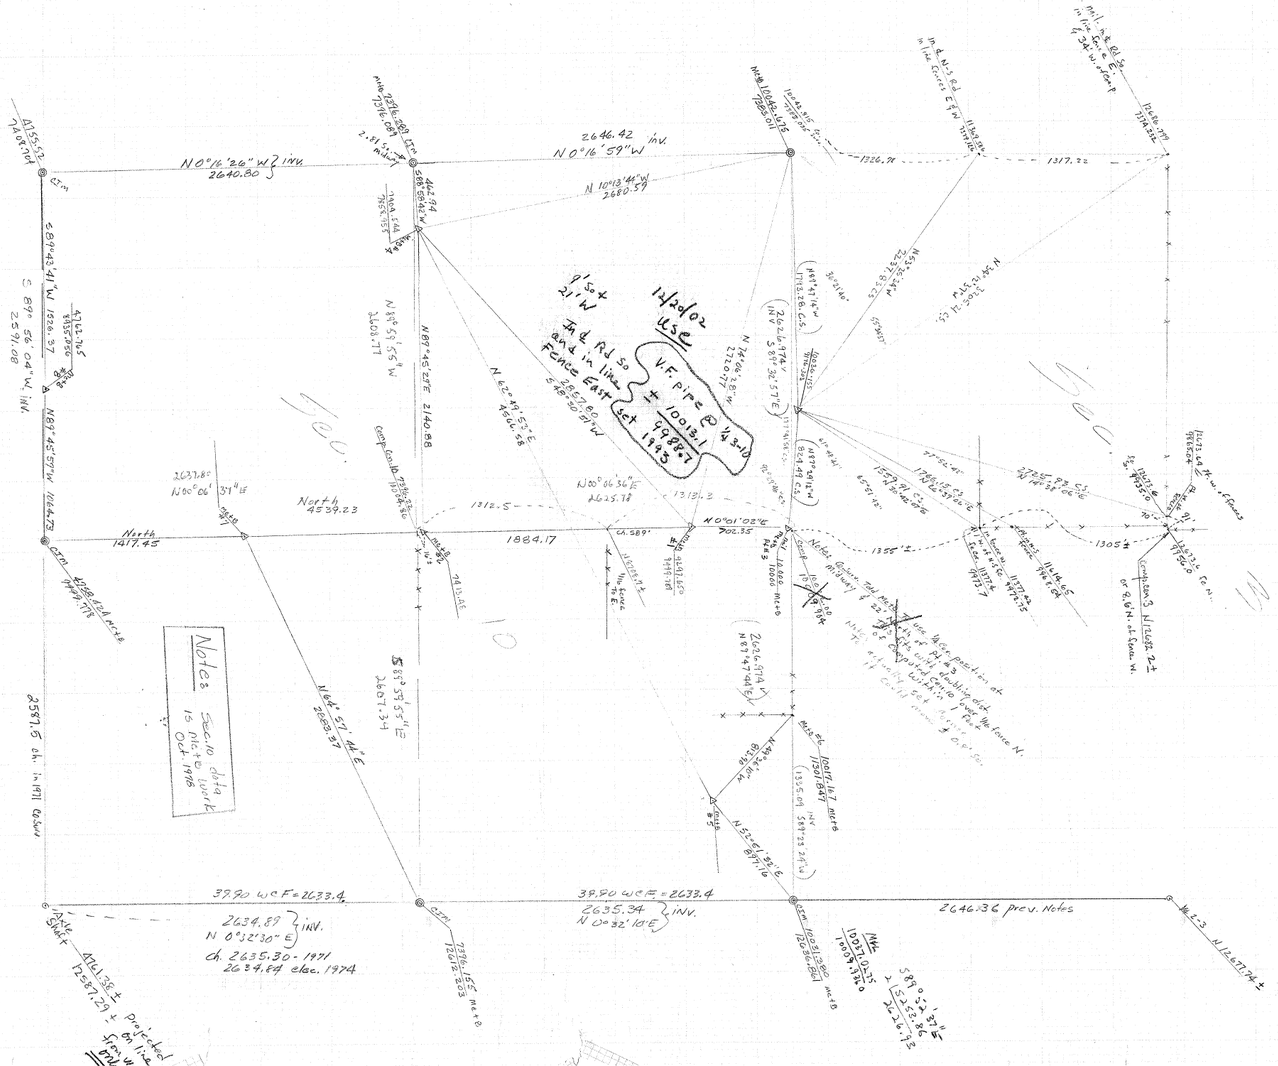

N 0°16'26" W 2 INV. 2640.80
2646.42 N 0°16'59" W INV.
N 10°13'44" W 2680.59
S 89°56'48" W 446.94
S 89°43'41" W 1058.37
S 89° 56' 04" W INV. 2591.06
N 89°45'57" W 1064.62
N 89°55'55" W 2609.77
N 89°45'22" E 2140.88
N 62°41'52" E 460.26
2633.80 N 00°06' 31" E
North 4539.23
North 1417.45
1312.5
1884.17
N 0°01'02" E 702.35
1326.71
1317.32
1305.4
1355'
S 89°59'55" E 2607.34
1164.57' M.E. 2588.37
2587.5 ch. in 1971 Govn
39.90 W.C.F. = 2633.4
2634.88 } INV. N 0°32'30" E
Ch. 2635.30 - 1971
2634.84 elec. 1974
2635.34 N 0°32'10" E } INV.
2646.36 prev. Notes
W.C.S. W 1/4 Sec. 3
Notes
9'S of 21' W
on W in line
Fence East
set 1983
12/20/02 USE
Fence Post on at
Rd Sd
