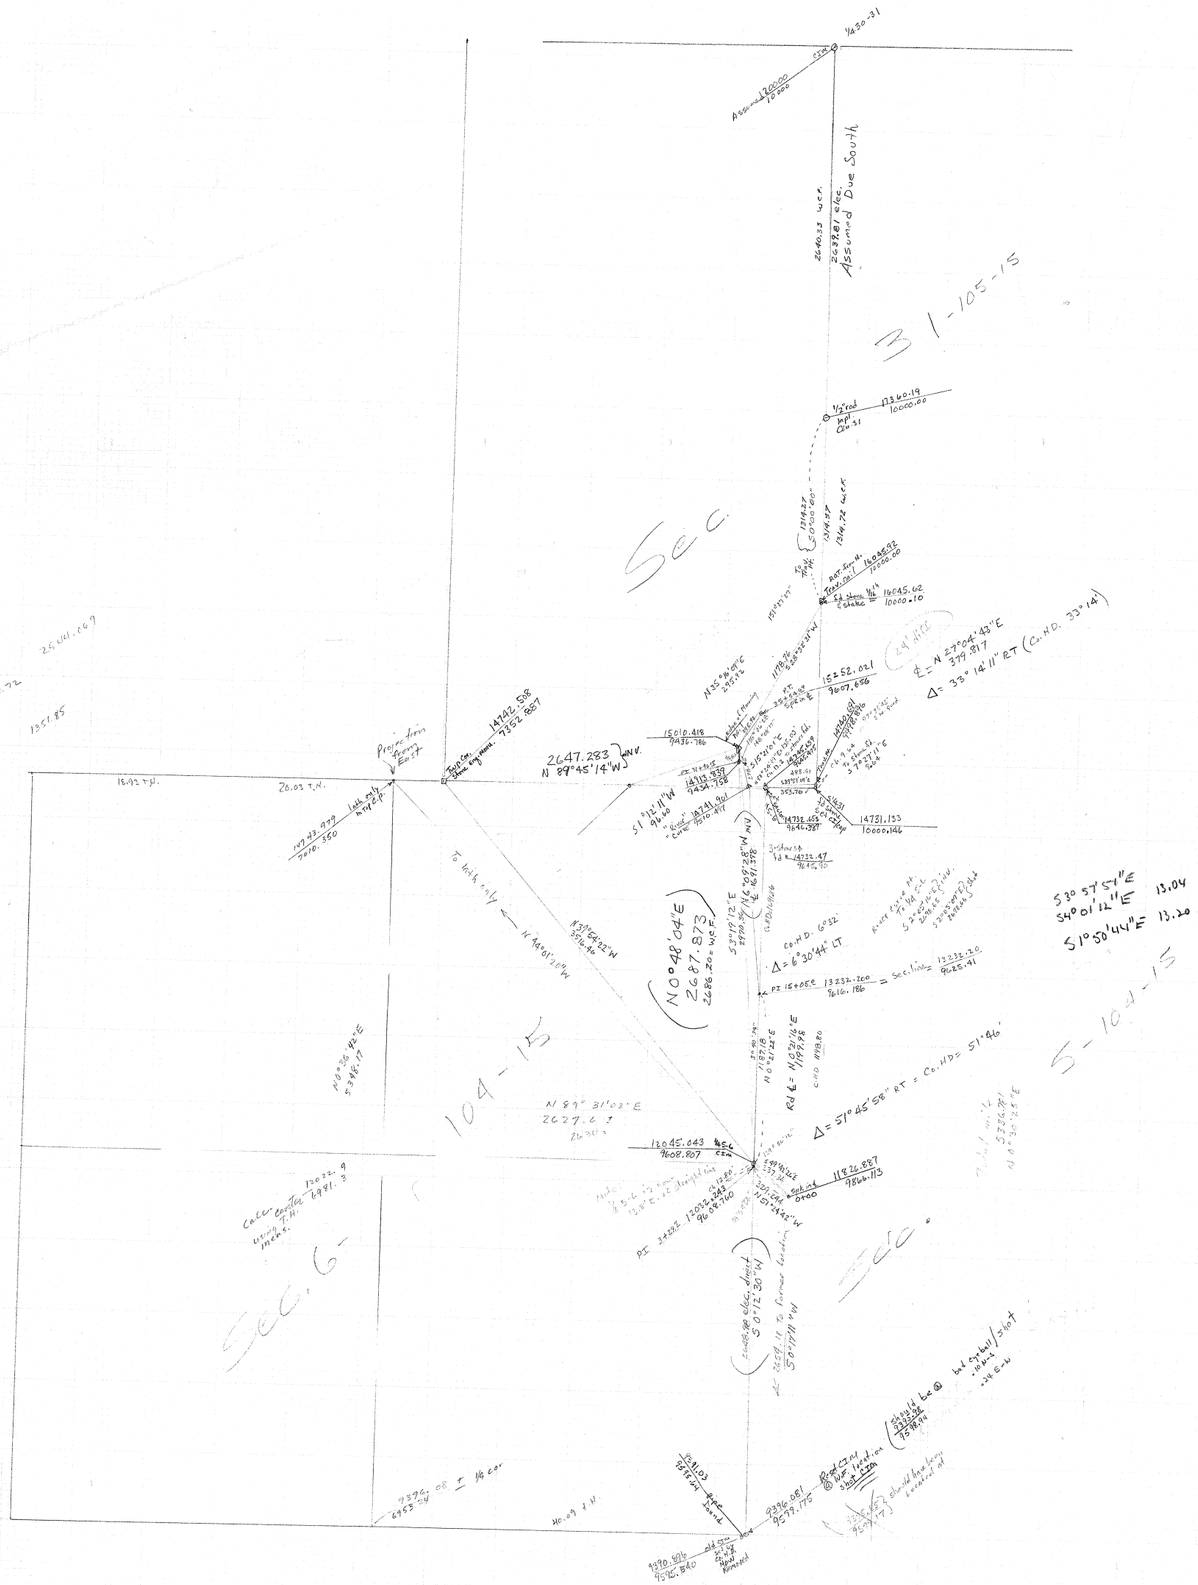

Assumed 2640.00
Assumed Due South
2640.33 wcm
2638.81 calc.
B 1-105-15
Sec
Sec. 6
Sec. 5
104-15
N 89° 31' 02" E
2627.63
N 0° 48' 04" E
2687.873
2686.20 wcm
Co. No. 6°32
Δ = 6° 30' 44" LT
Δ = 51° 45' 58" RT = Co. No. = 51° 46'
S 30° 57' 51" E 13.04
S 40° 01' 22" E 13.20
Δ = 33° 14' 11" RT (Co. No. 33° 14')
N 89° 45' 14" W
2647.283 wcm.
