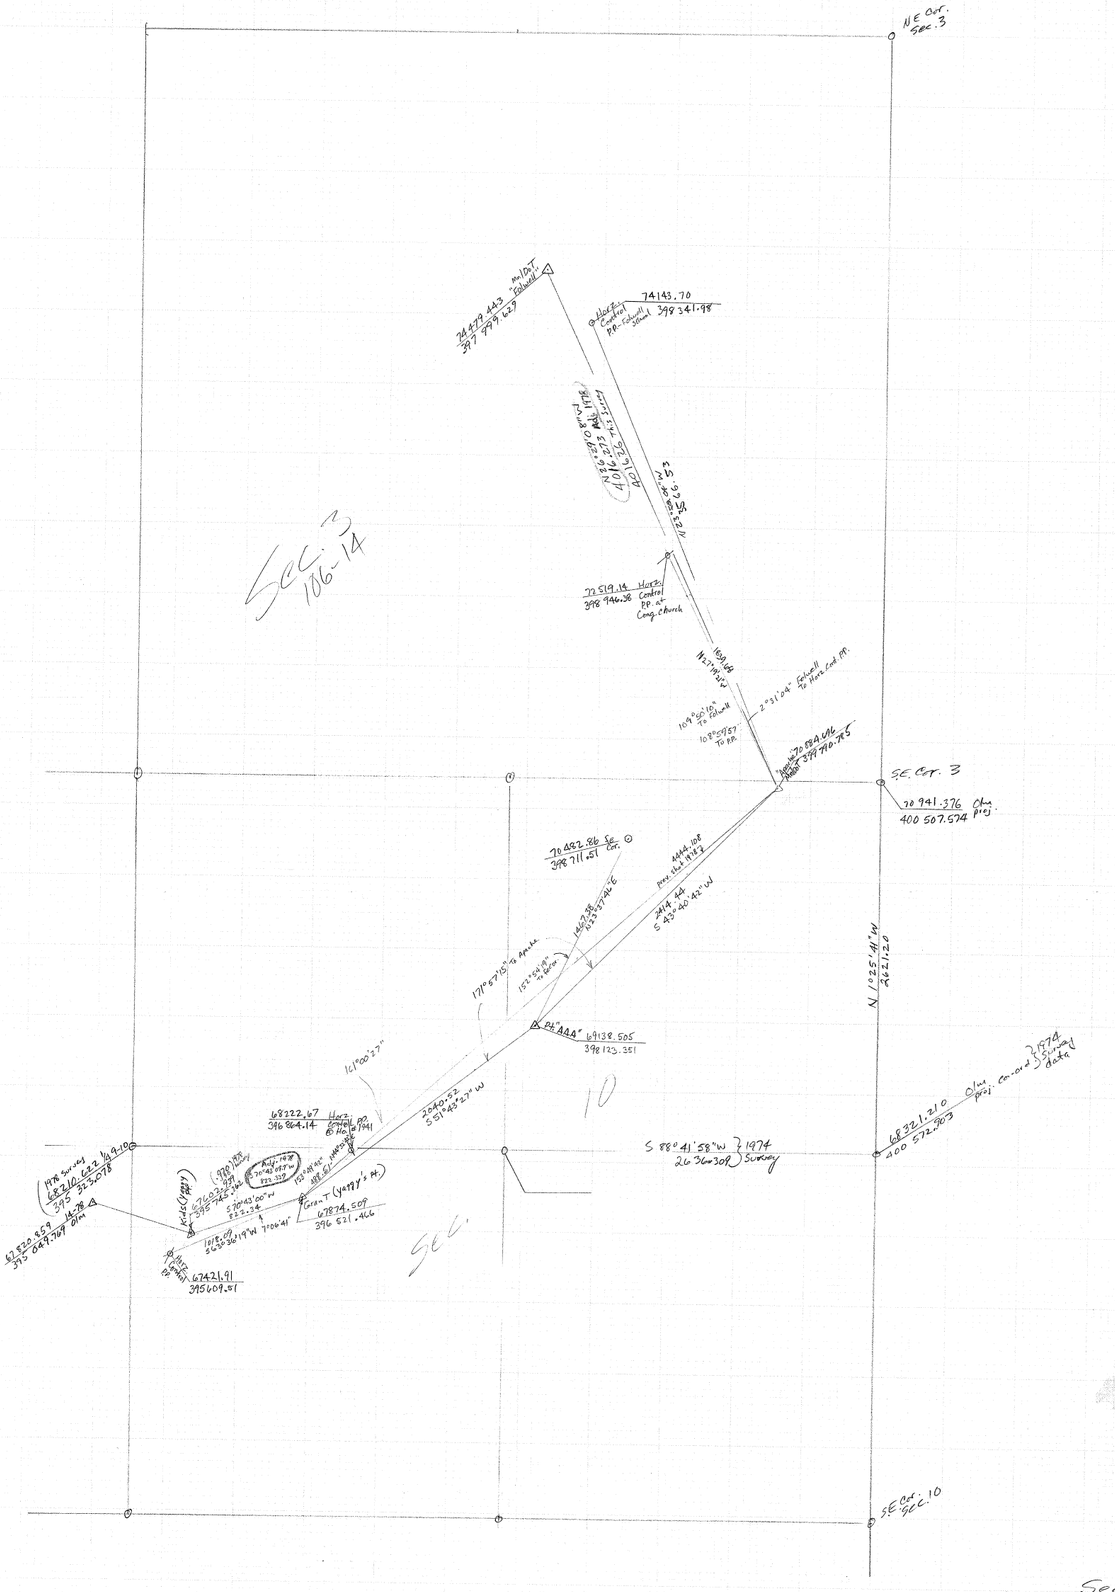


Sections 3 and 10, 106-14
Rochester Twp.
Ground Control for
Aerial Photos - July, 1979

4-40

Drwg 4-40