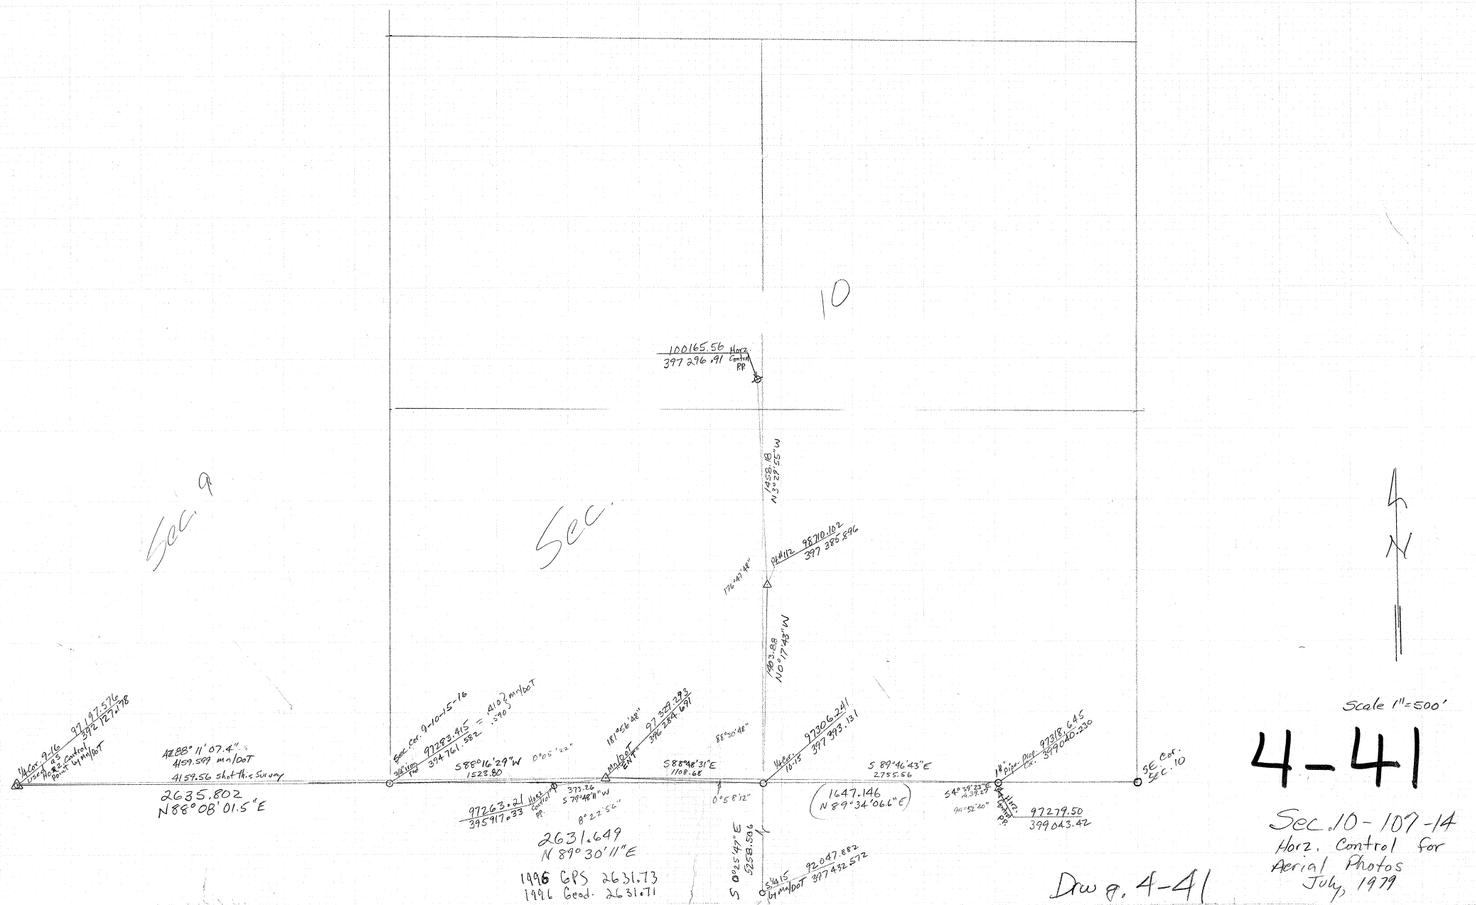

10
Sec. 9
Sec.
100165.56
397 296.191
Horz. Control PP
1428.18
N1°29'55"W
178°49'48"
1483.58
N0°17'48"W
Sec. Cor. 9-10-15-16
977383.815
314 761.582
588°16'29"W
1525.80
2635.802
N88°08'01.5"E
2631.649
N 89°30'11"E
1996 GPS 2631.73
1996 Geod. 2631.71
1647.146
N 89°34'06.6"E
S 89°46'43"E
2755.56
S 0°25'49"E
3528.806
SE Cor. Sec. 10
97279.50
399 043.42
Scale 1"=500'
4-41
Sec. 10-10N-14
Horz. Control for
Aerial Photos
July, 1979
Dwg. 4-41