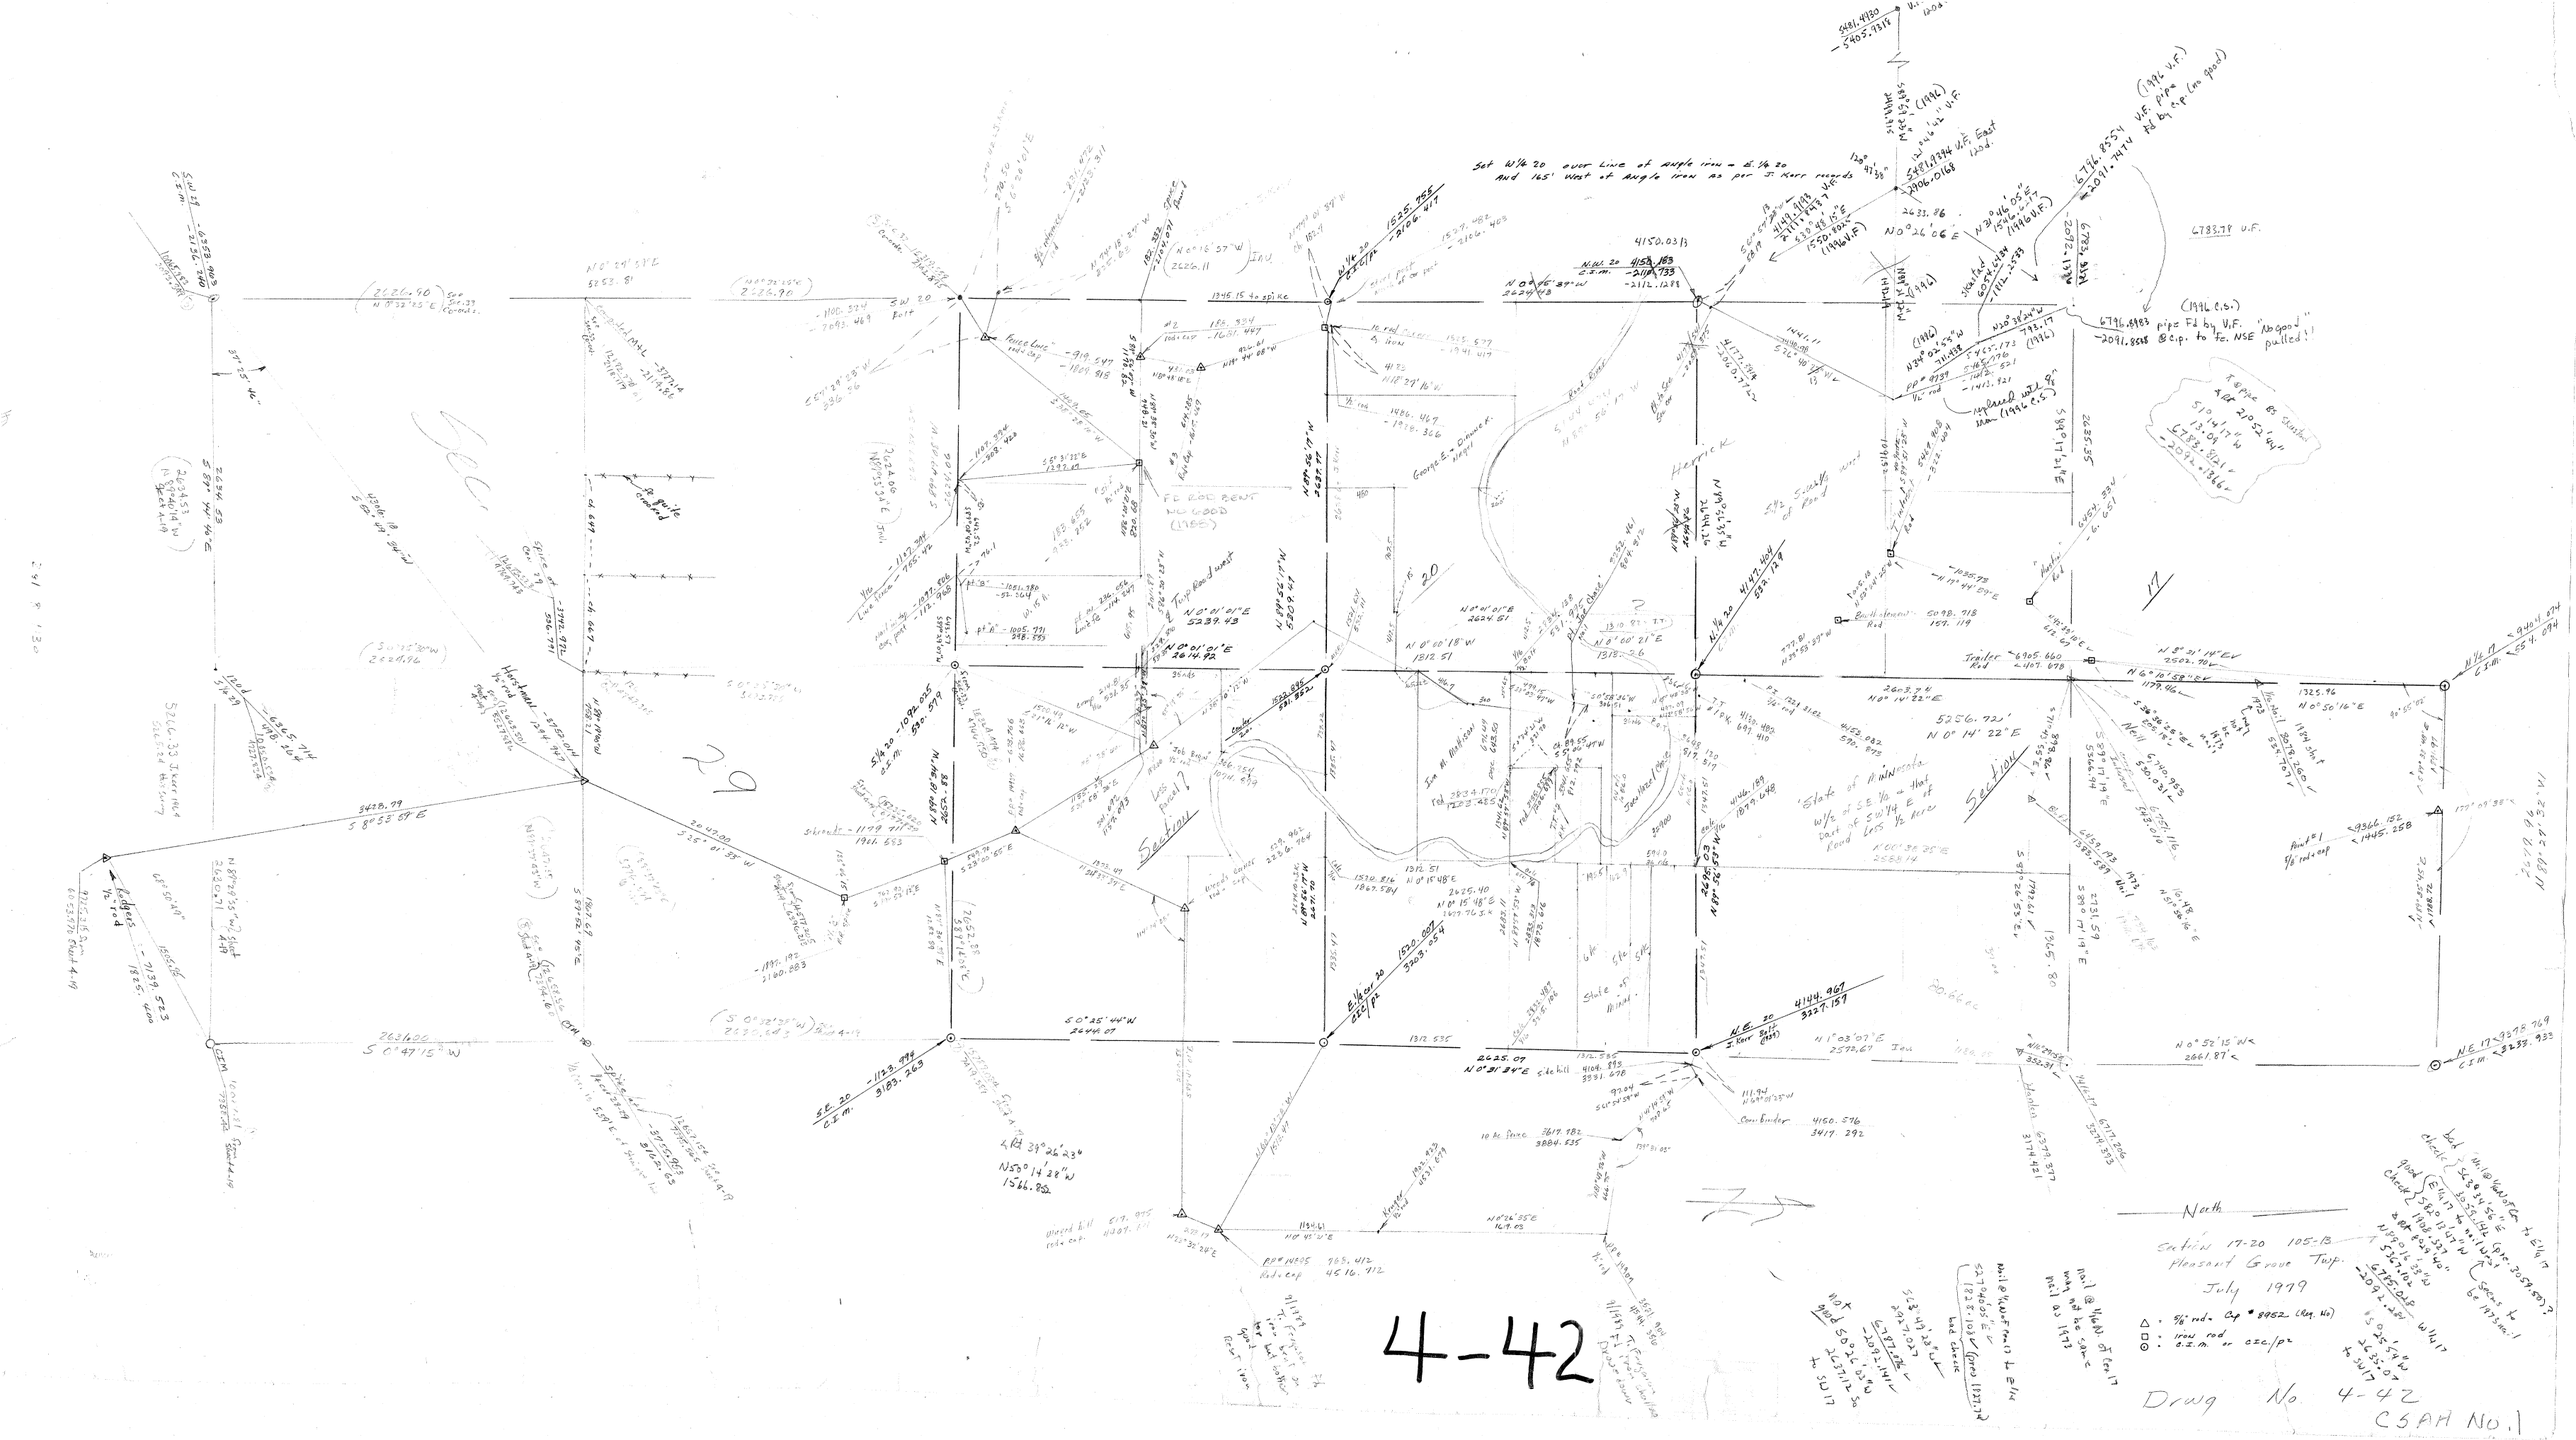

Set W1/16 20 over Line at angle iron = E. 1/4 20 and 165' West at angle iron as per J. Kerr records
Section 17-20 105-13
Pleasant Grove Twp.
July 1979
△ : 5/8" rod. Cap # 8952 (Reg. No)
□ : iron rod
⊙ : o.i.m. or o.i.c/pc
Drwg No. 4-42
CSAM No. 1
4-42