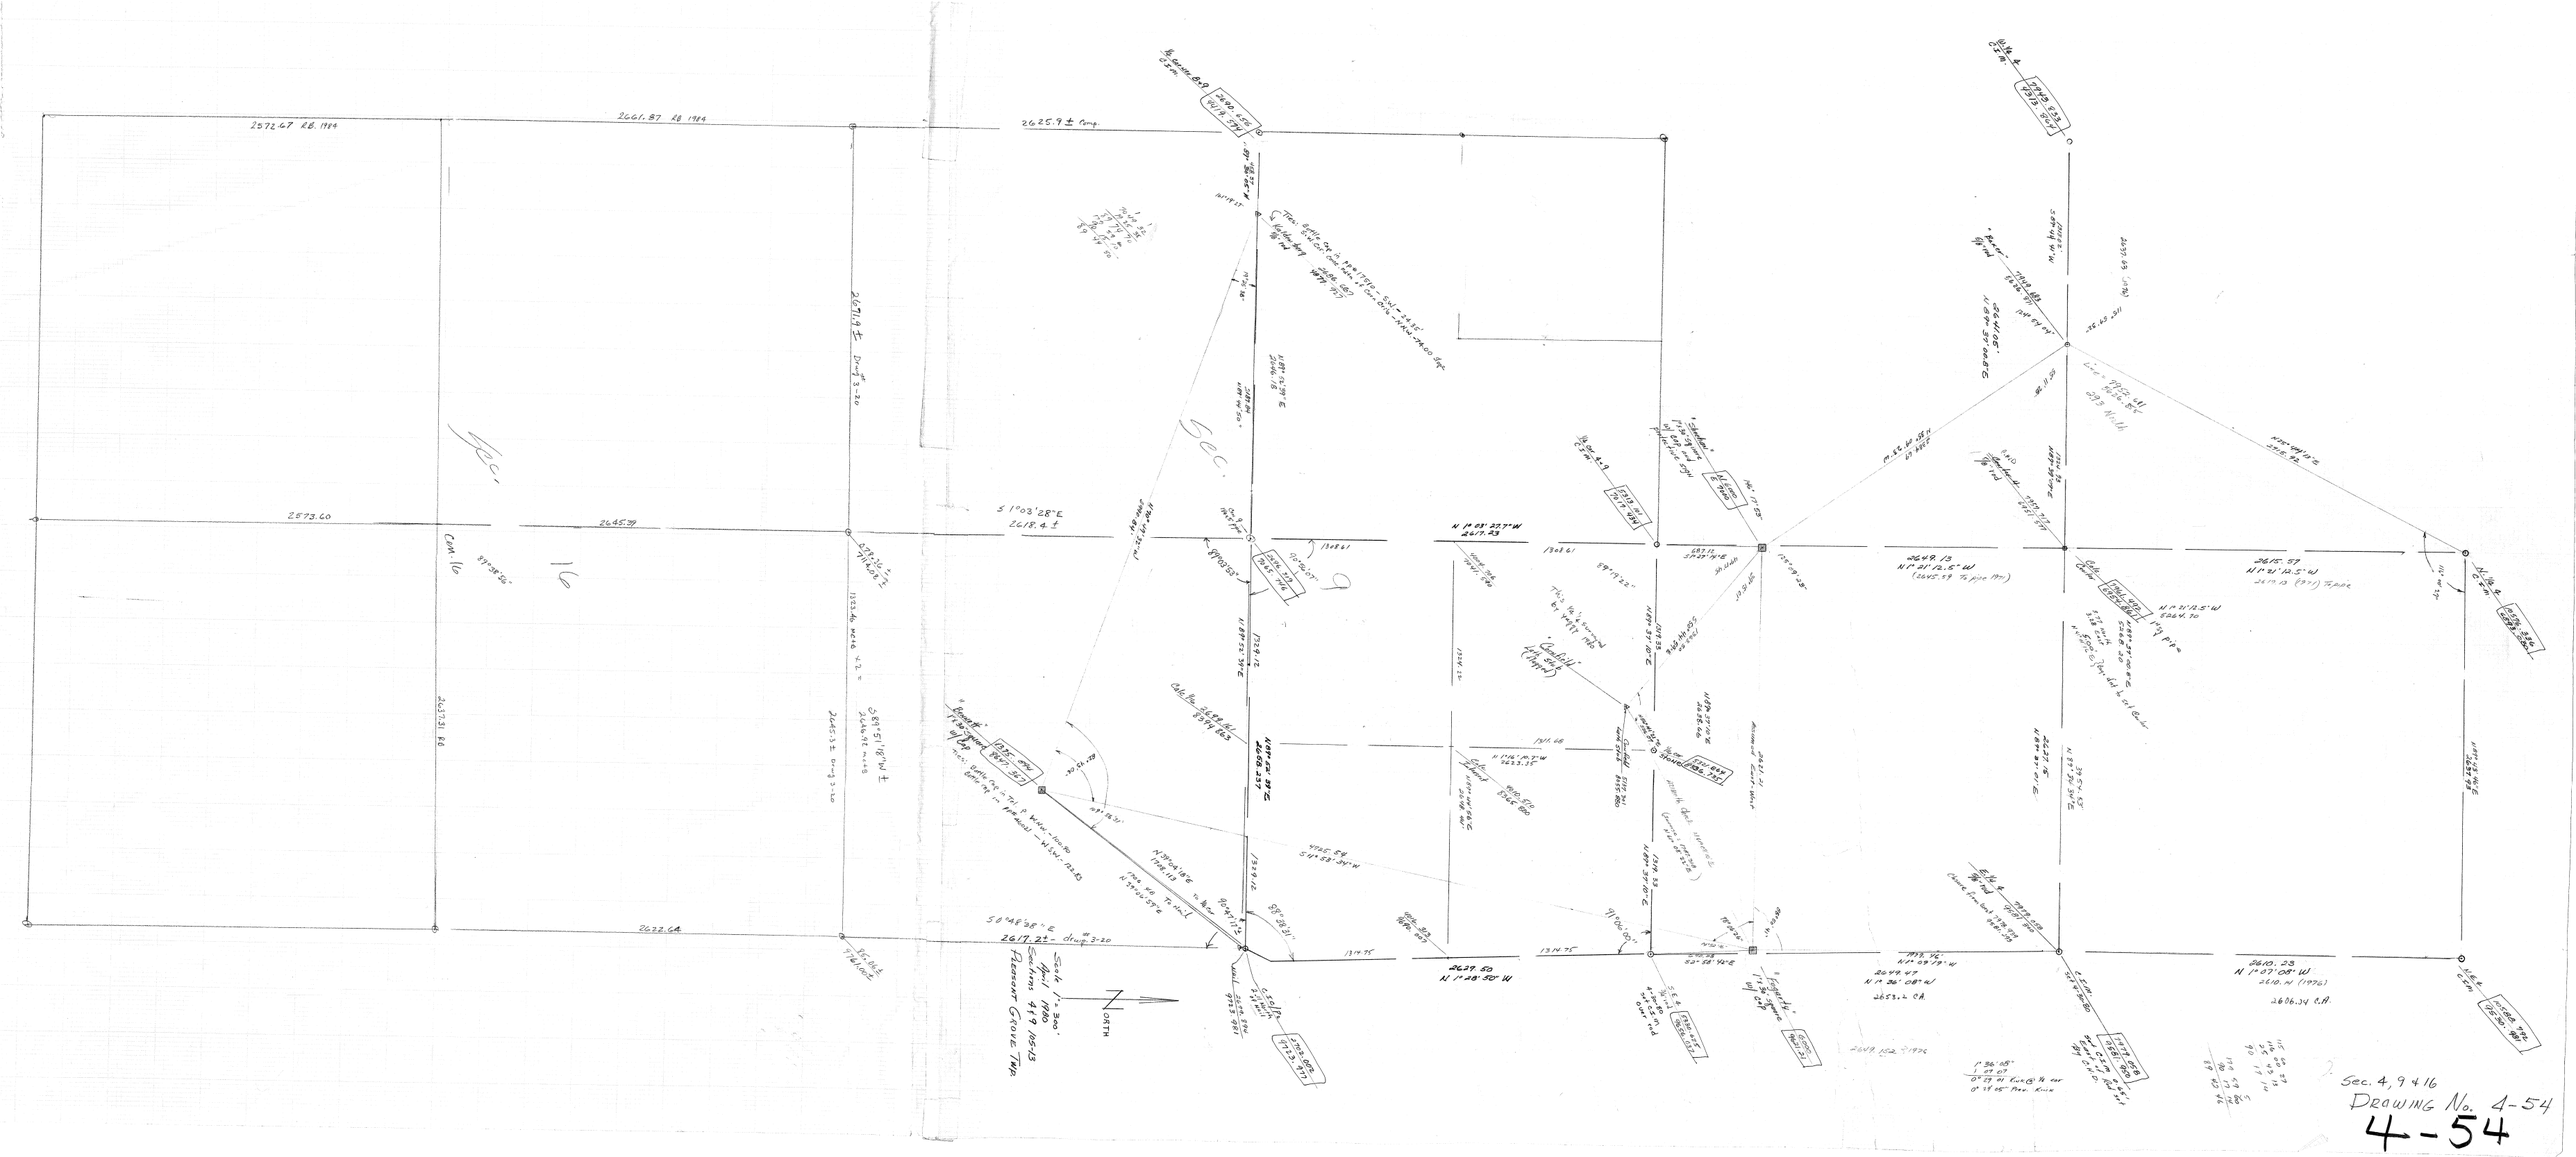

Sec. 9
Sec. 16
2572.67 RB. 1984
2661.87 RB. 1984
2625.9 ± Comp.
2671.9 ± Dr. 3-20
2573.60
2645.39
2637.86
2622.64
2617.23 - drug. 3-20
S 1°03'28" E
2618.4 ±
S 89°51'18" W ±
2646.92 meas.
2645.3 ± Dr. 3-20
S 0°48'38" E
Scale 1" = 300'
April 1980
Pleasant Grove Twp.
NORTH
N 1°03'27.7" W
2617.23
N 1°28'50" W
2629.50
N 1°21'12.5" W
2649.13
(2645.59 Tie Pipe)
N 1°21'12.5" W
2615.57
(2617.13 (1971) Tie Pipe)
N 1°07'08" W
2610.33
(1976)
2606.34 C.A.
2649.47
N 1°39'08" W
2653.4 C.A.
2649.152 (1976)
DRAWING No. 4-54
4-54