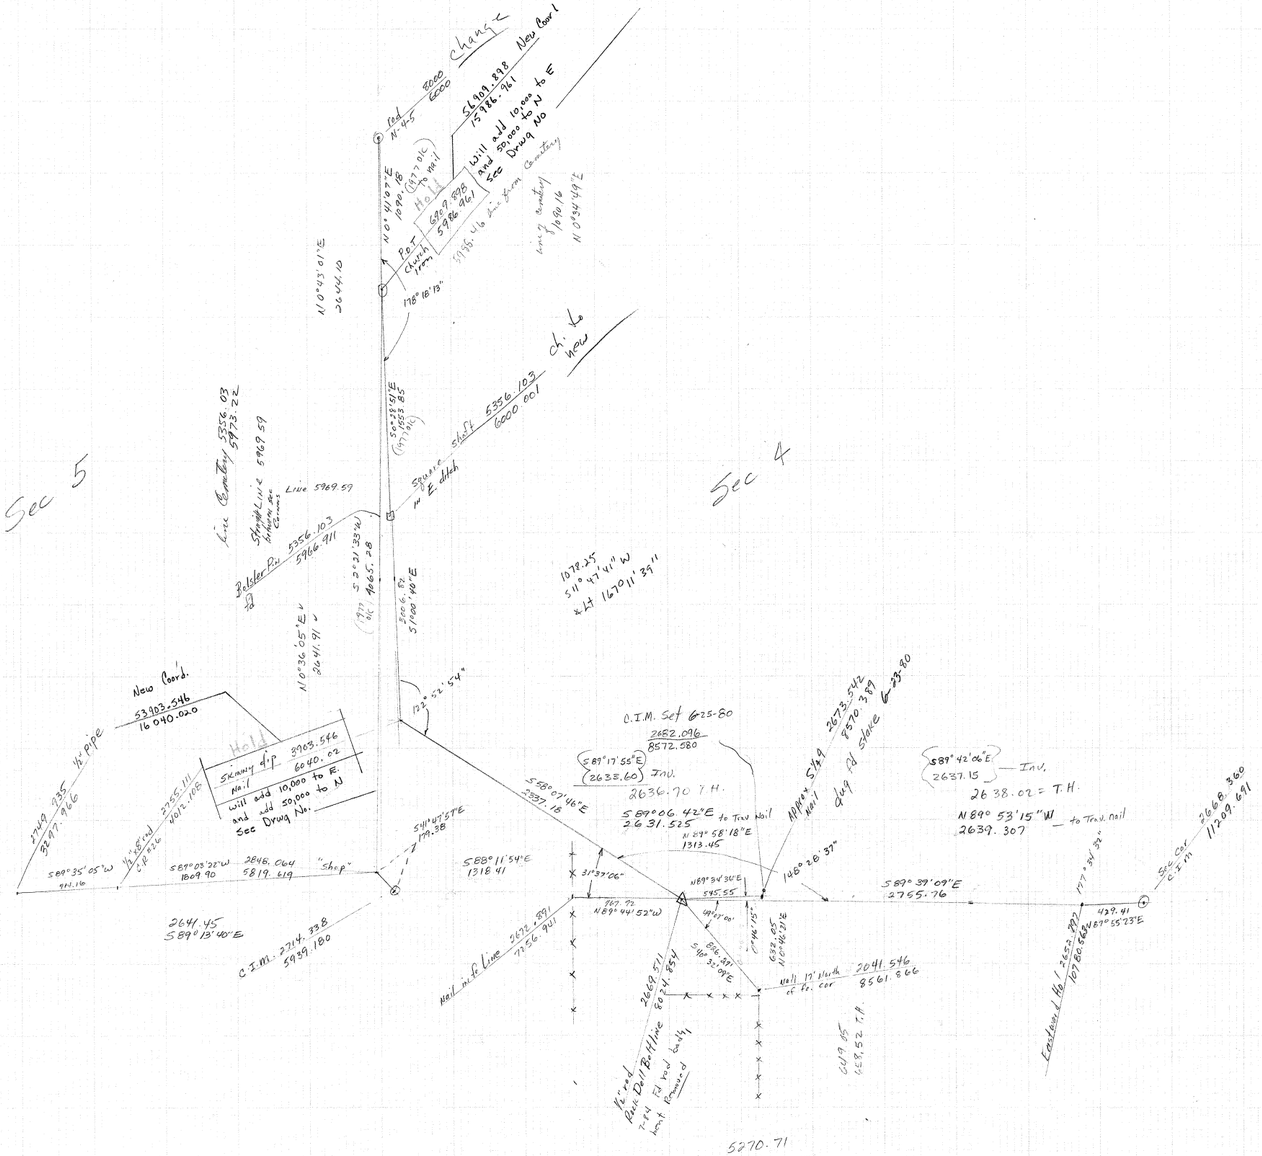


Sections 4+5 10S-15
Rock Dell Twp
June 1980

4-58 Drawing No 4-58