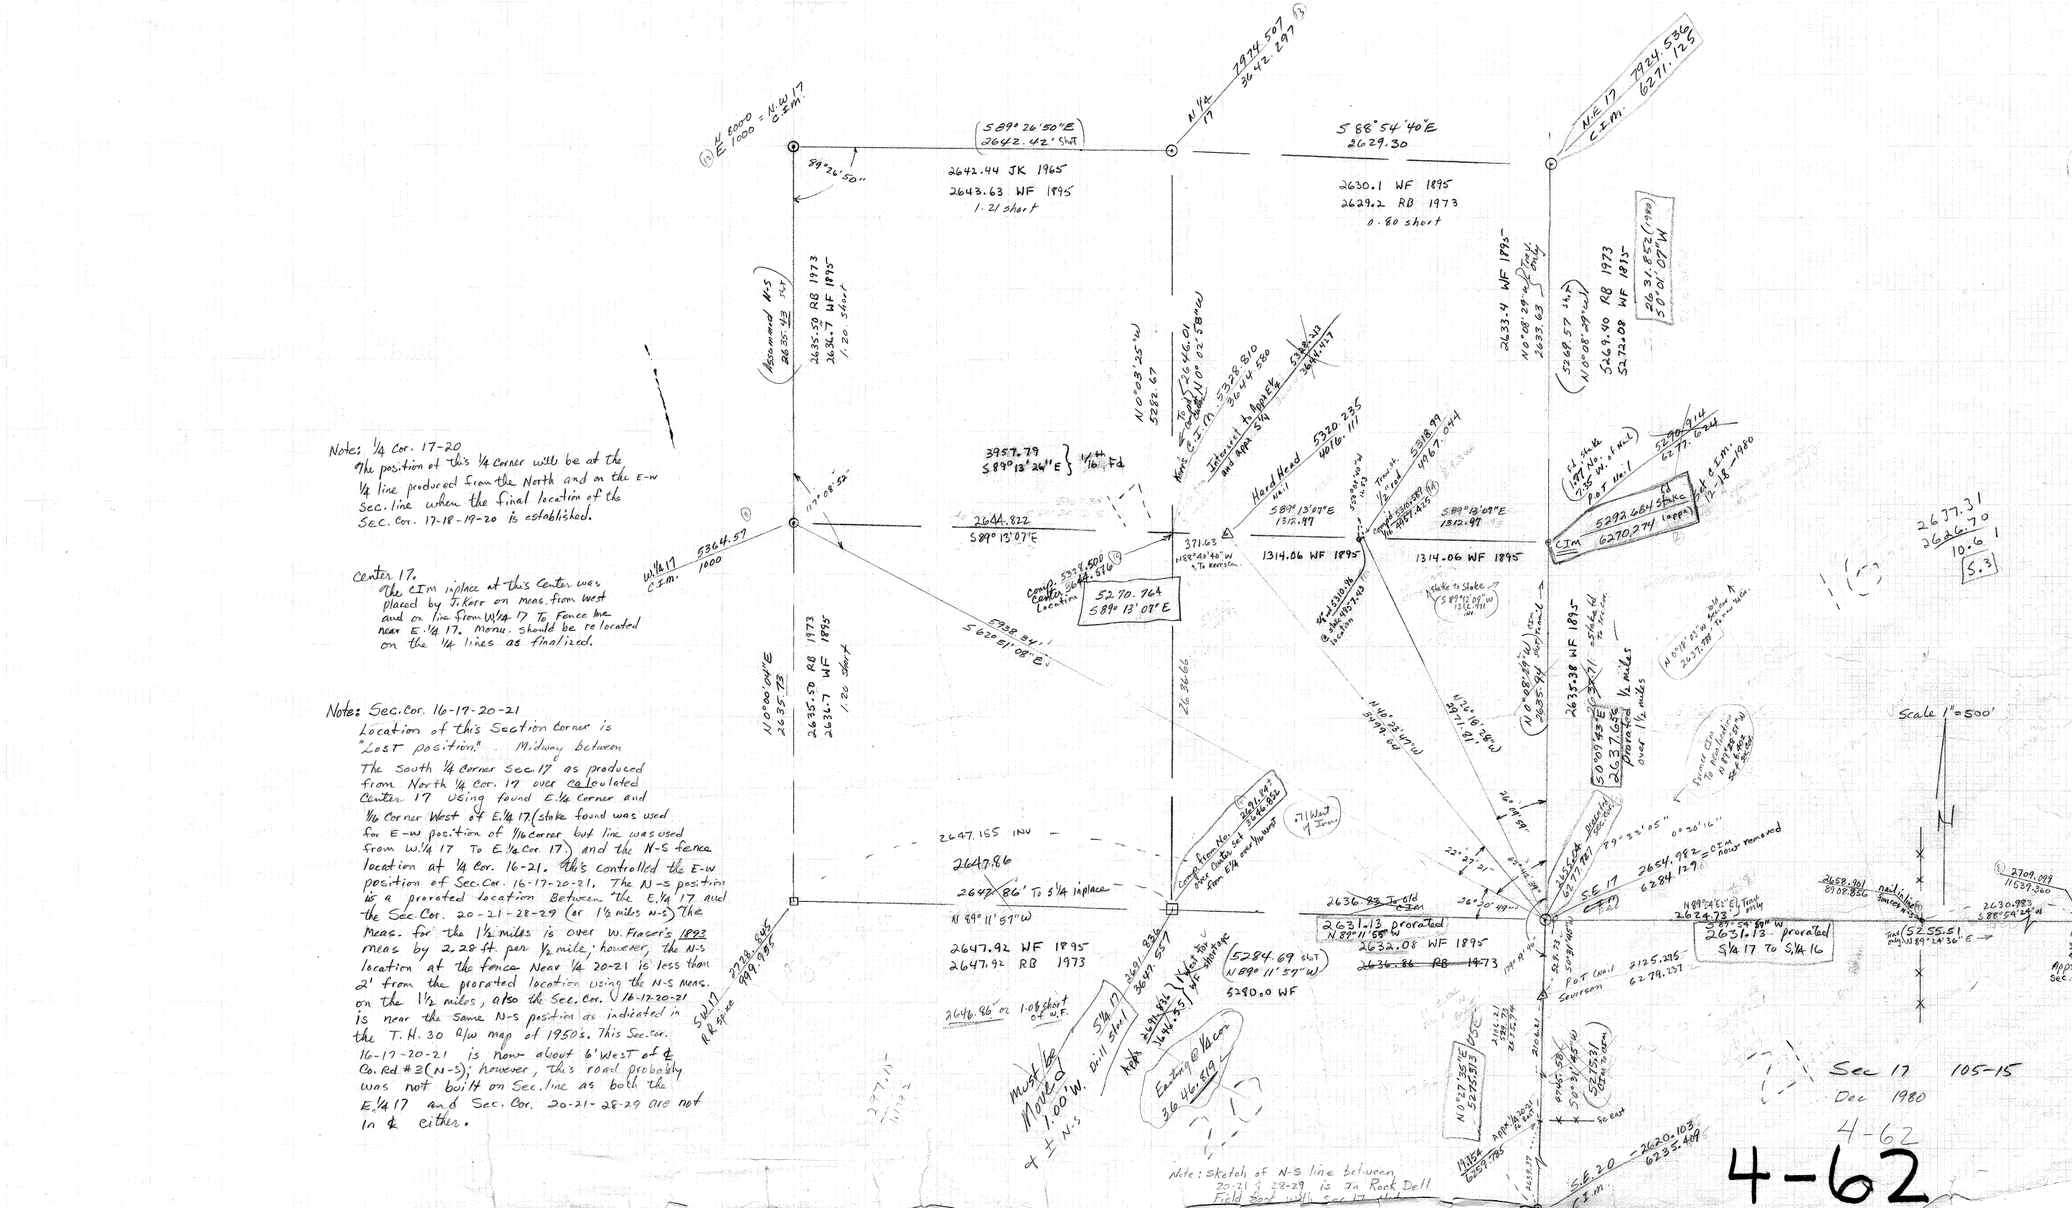

Note: 1/4 Cor. 17-20
The position of this 1/4 Corner will be at the 1/4 line produced from the North and on the E-W Sec. line when the final location of the Sec. Cor. 17-18-19-20 is established.
Center 17.
The CIm in place at this Center was placed by T. Kerr on meas. from west and on line from W1/4 17 To Fence NE near E 1/4 17. Monu. should be relocated on the 1/4 lines as finalized.
Note: Sec. Cor. 16-17-20-21
Location of this Section Corner is "LOST position." ... Midway between
The South 1/4 Corner Sec. 17 as produced from North 1/4 Cor. 17 over calculated Center 17 using found E 1/4 Corner and 1/16 Corner West of E 1/4 17 (stake found was used for E-W position of 1/16 corner but line was used from W 1/4 17 To E 1/4 Cor. 17) and the N-S fence location at 1/4 Cor. 16-21. This controlled the E-W position of Sec. Cor. 16-17-20-21. The N-S position is a prorated location Between the E 1/4 17 and the Sec. Cor. 20-21-28-29 (or 1 1/2 miles N-S) The Meas. for the 1 1/2 miles is over W. Fraser's 1893 meas by 2.28 ft. per 1/2 mile; however, the N-S location at the fence Near 1/4 20-21 is less than 2' from the prorated location using the N-S meas. on the 1 1/2 miles, also the Sec. Cor. 16-17-20-21 is near the same N-S position as indicated in the T. H. 30 R/W map of 1950's. This Sec. Cor. 16-17-20-21 is shown about 6' West of & Co. Rd #3 (N-S); however, this road probably was not built on Sec. line as both the E 1/4 17 and Sec. Cor. 20-21-28-29 are not in & either.
Scale 1"=500'
Sec 17 105-15
Dec 1980
4-62
4-62