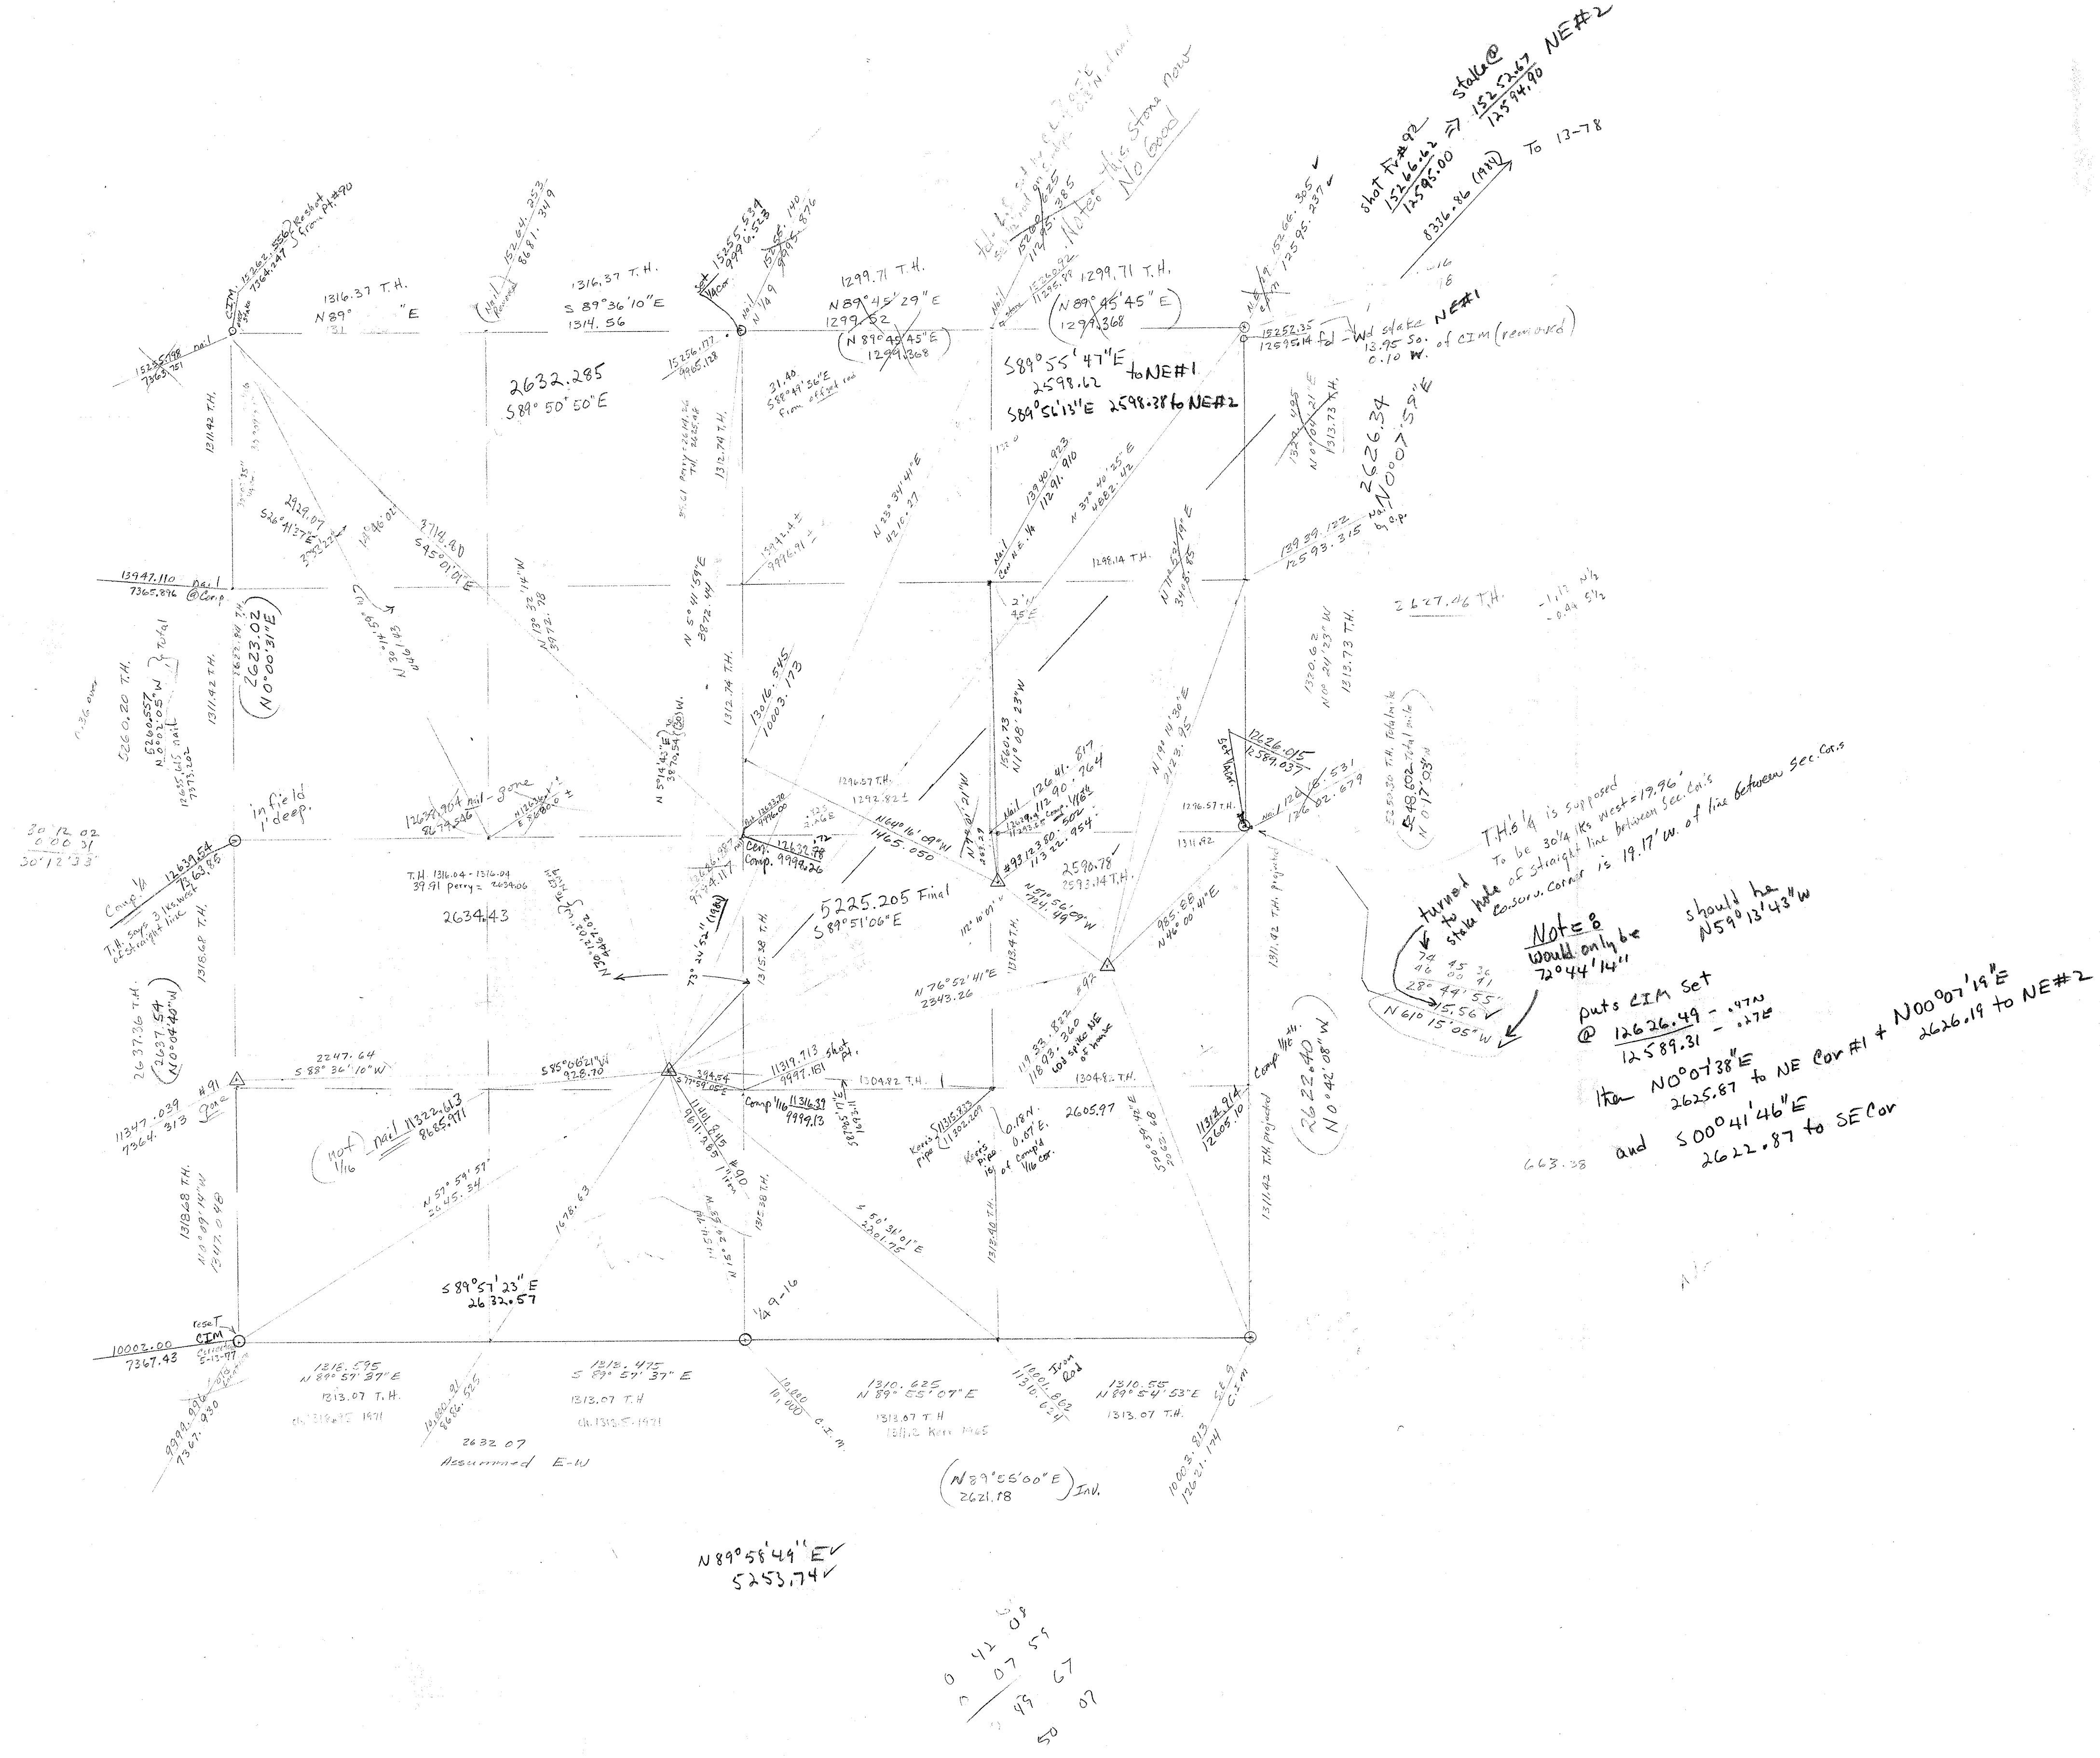


4-8

Sec 9 – Salem
Apr + May 1977

Drwg 4-8